

Stafford

FORM 51


KANSAS

Section 6 Township 21 Range 11W

Well No. 2 - Peterson

Company Veeder Supply

NORTH

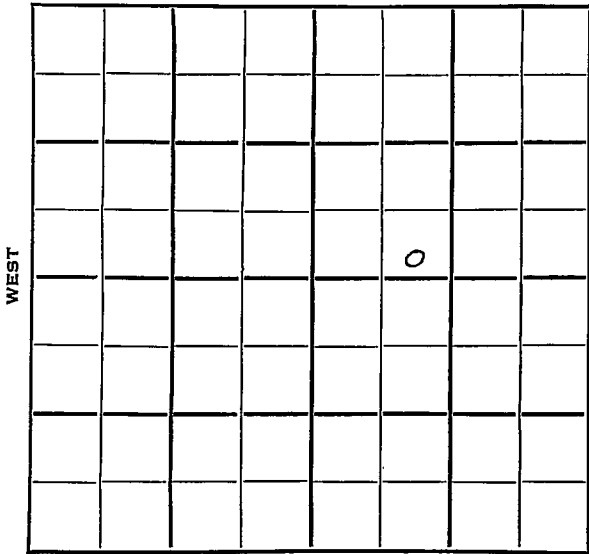

SOUTH

Stafford

KANSAS ✓

Sec. 6 Twp. 21 R. 11W

Well No. 2 Peterson Farm

Veeder Supply Company

Buick Contractor


_____ Ft. from N. Line

330 Ft. from S. Line

_____ Ft. from E. Line

990 Ft. from W. Line

SE SW NE

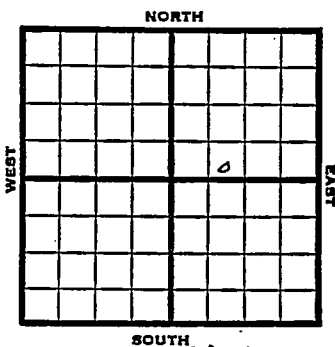

1952 Elev. 1809' REPORT Elv. 1809

12/30 Spudding 12/21/52, 8" @ 316
Drlg. 2350

1/1 Drlg. 2350
1/8 NR

1953
1/14 Spud 12-21-52
D&A TD 3513
8" @ 316
Heeb 3008, Br lime 3128, KC
3146
DST 3278-95, opn 1/2 hr., rec.
10' mud, 0#
Cong 3394, Simp 3467, Arb.
3486
TD 3513,
D&A

ABANDONED

County Stafford State Kansas

Sec. 6 (Blk. Twp.) 21 (Sur. Rge.) 11W Map No.

Operator Veeder Supply

Well No. 2 Farm Peterson

Elev. 1809 Location SE SW NE

330 Ft. From S Line NE

990 Ft. From W Line Quarter

Ist. Report DEC 30 1952

Completion _____

Remarks _____

Buick - Contr.

Spudding Date 12-21-52

Drlg. Data _____

8" @ 316 drlg. 2350

