


Section 6 Township 21 Range 11W

Well No. #2 Ringering

Company Penguin Drlg.

NORTH

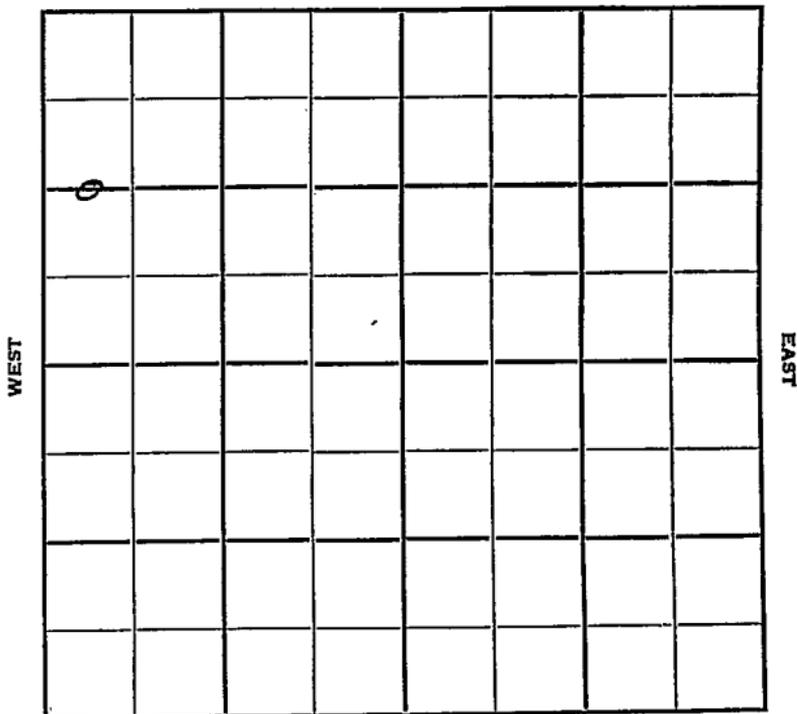

SOUTH

Sec. 6 Twp. 21 R. 11 W

Well No. # 2 Ringering Farm

Penguin Drlg. Company

Ash-Murfin Contractor


1320 Ft. from N. Line

_____ Ft. from S. Line

_____ Ft. from E. Line

330 Ft. from W. Line

C $W\frac{1}{2}$ $W\frac{1}{2}$ NW

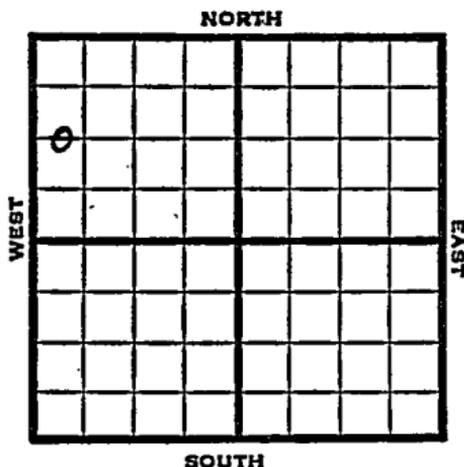

1951 Elev. 1823' REPORT

2/14 Spud 2-10-51
8" @250
Drlg. 2050

2/28 Spud 2-10-51
D&A TD 3509
8" @ 250
Heeb. 3013 Lans. 3157
Arb. 3506
TD 3509 5" @ 3509
GO to 3364 13/3336-39 28/3293-33
D&A
ABANDONED

