

Section 7 Township 21 Range 13W

Well No. #1 DeBusk

Company Mid-States Oil

NORTH

				0			

WEST

EAST

SOUTH

Stafford KANSAS

Sec. 7 Twp. 21 R. 13W

Well No. #1 DeBusk Farm

Mid-States Oil Company

Harber Drlg. Contractor
Dell Pool


330' Ft. from N. Line

_____ Ft. from S. Line

_____ Ft. from E. Line

330' Ft. from W. Line

NW NW NE

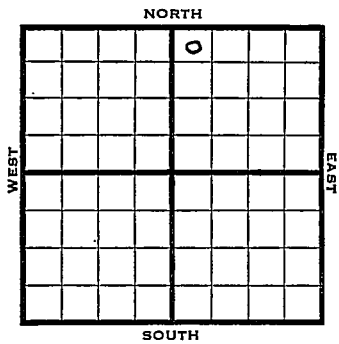

1950 Elev 1916 REPORT

9/13 Spud 9-10-50
8-5/8" @ 312'
WOC

9/27 8 5/8" @ 312
Lans 3332
DST 3461-69 open 1 hr rec 3000' sw
Viola 3558
DST 3556-92 open 1 hr rec 20' mud
Simp 3598 Arb 3655
TD 3680
D&A

ABANDONED

County **Stafford** State **Kansas**

Sec. **7** (Blk. Twp.) **21** (Sur. Rge.) **13W** Map No.

Operator **Mid-States Oil**

Well No. **1** Farm **DeBusk**

Elev. Location **NW NW NE**

		10			

FIRST REPORT

330 Ft. From **N** Line **NE**,

330 Ft. From **W** Line Quarter

1st. Report **SEP 13 '50**

Completion

Remarks

Stanolind farmout

Spudding Date **9-10-50**

Drilg. Data **Dell Pool**

8 5/8" @ 312 WOC

J. E. TYRA

