


Section 7 Township 21 Range 13 W

Well No. # 1 Witt

Company Petroleum Inc.

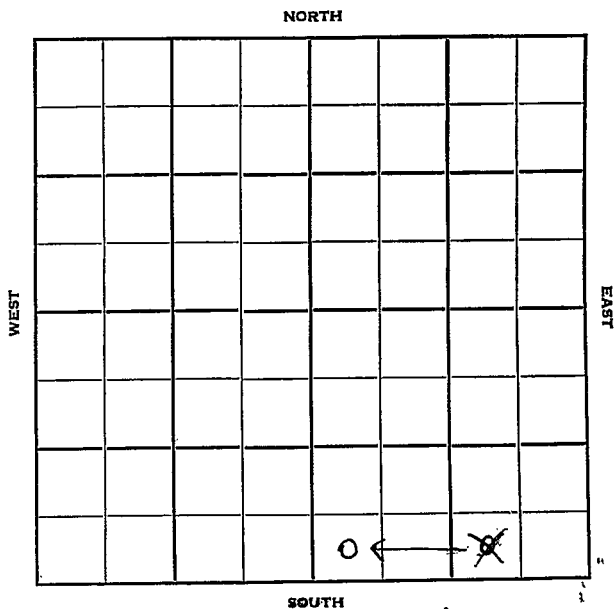

Stafford

KANSAS

Sec. 7 Twp. 21 R. 13W

Well No. #1 Witt Farm

Petroleum, Inc. Company

Buick - Contr. Contractor


 Ft. from N. Line

330' Ft. from S. Line

990' Ft. from E. Line

330 Ft. from W. Line

SW SW SE
SW SE SE

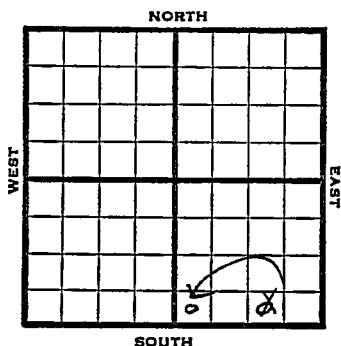

1951 Elev. 1911' REPORT

12/19 Spud 12-15-51
8" @ 244
Drlg. 1000'

1952
2/6

TD 3660' 5" @3562

2/13

Spud 12-15-51

Oil Well TD 3660

8" @ 244 Heeb. 3203

Br lime 3322 Lans. 3332

DST 3399-3422 opn $\frac{1}{2}$ hr

Rec. 30' hocm 240' oil,

DST 3473-3501 opn 20 min.

Rec. 1710' oil Viola 3569

Simp 3589 Arb. 3644 TD 3660

5" @ 3562 48/3493-3504 31/3494-3504

$\frac{1}{2}$ boph 2000 A 20 boph 31/3475-85

30 boph Comp. 972 bopd


COMPLETED

County Stafford State Kansas
 Sec. 7 (Blk.) 21 (Sur.) 13W Map No.

Operator Petroleum Inc.

Well No. 1 Farm Witt

Elev. Location SW SE SE

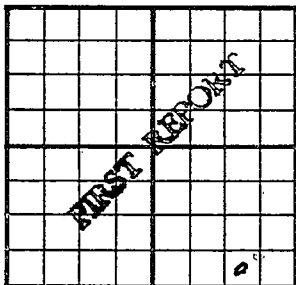

330 Ft. From S Line SE

990 Ft. From E Line Quarter

1st. Report DEC 1 0 1951

Completion

Remarks

Buick - Contr.

Spudding Date 12-15-51

Drlg. Data

8" @ 244 Drlg. 1000

J. E. TYRA

DEC 31 1947

Scout Cards	_____
Land Small Map	_____
Land Wall Map	_____
Tracings	_____
France Map	_____
Pierce Map	_____
Misc.	_____

Brig. Data

Map No. _____ Sec. 7 Twp. 21 R. 13WWell No. 1 Witte

_____ Petroleum Inc. _____ Company

CORRECTION

_____ Contractor

SW SW SE

SECTION PLAT

_____ Ft. from N. Line

330 Ft. from S. Line

_____ Ft. from E. Line

330 Ft. from W. Line

Stafford County

Location _____

Rig up _____

Drilling and Remarks:

Reported

SW SE SE

RECORD

Cased _____ in., _____ ft.

Sand _____

Gas _____

Oil _____

Total Depth _____

PRODUCTION

1st 24 hrs. Nat. _____

1st 24 hrs. after shot _____

Gas _____ Cu. Ft.

Dry Hole _____

Abandoned _____

Date

DEC 1 9 1951

19

J. E. TYRA

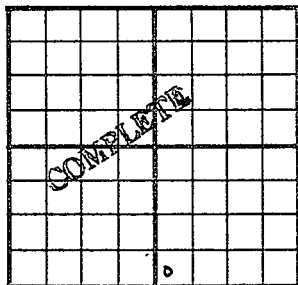
Scout

TABLE NO. 10

TABLE NO. 10

Scout Cards	_____
Land Small Map	_____
Land Wall Map	_____
Tracings	_____
France Map	_____
Pierce Map	_____
Misc.	_____

JAN 2 1952

County Stafford State KansasSec. 7 (Blk. Twp.) 21 (Sur. Rge.) 13W Map No.Operator Petroleum Inc.Well No. 1 Farm WittElev. 1911 Location SW SW SE330 Ft. From S Line SE330 Ft. From W Line Quarter1st. ReportCompletion FEB 13 1952RemarksBuick - Contr.Spudding Date 12-15-51Drilg. Data Oil well TD 36608" @ 244 Heeb. 3203 Br. lime 3322Lans. 3332 DST 3399-3422 open $\frac{1}{2}$ hr.Rec. 375' sw DST 3451-62 open 20 min.Rec. 30' hocm 240' oil DST 3473-3501open 20 min. Rec. 1710' oil Viola 3569Simp. 3589 Arb. 3644 TD 3660 5" @ 356248/ 3493-3504 31/ 3494-3504 $\frac{1}{2}$ boph2000 A 20 boph 31/ 3475-85 30 bophComp. 972 bopd

Scout Cards	
Land Small Man	
Land Wall Man	
Tracings	
France Map	
Pierce Map	
Misc. ..	

FEB 20 1952