


Stafford **KANSAS**

Section 7 Township 21 Range 14W

Well No. #4 Frey

Company Vickers

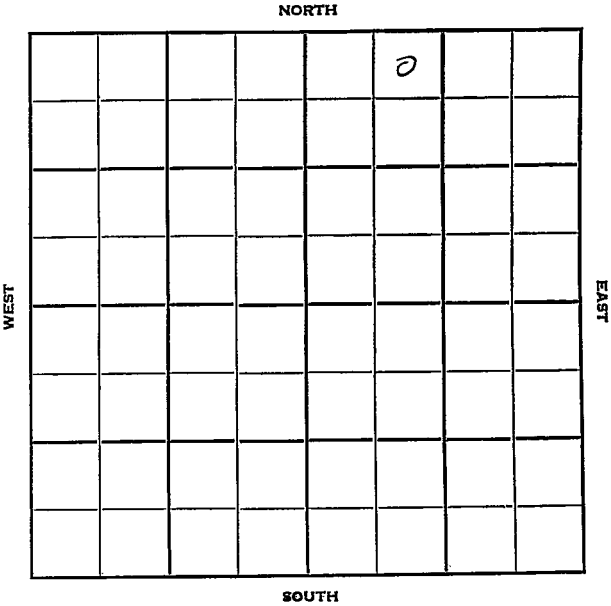

Sec. 7 Twp. 21 R. 14W ✓

Well No. #4 Frey Farm

Vickers

Company

Frey Pool

Contractor


330' Ft. from N. Line

Ft. from S. Line

Ft. from E. Line

990' Ft. from W. Line

NE NW NE

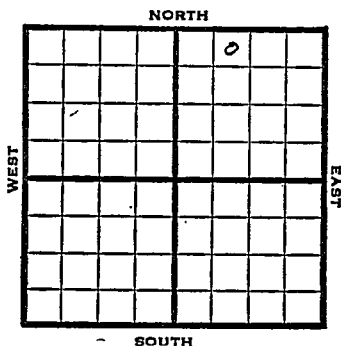

1950

Elev. 1927 REPORT

11/22

Spud 11-16-50
8" @ 881'
Anhy 876'

Drlg. 2150'

12/27

Spud 11-16-50
Oil Well TD 3710
Anhy 876'
8" @ 881'-
Heeb. 3256' Lans. 3356
Viola 3616 Simp. 3648
Arb. 3692-98 5" @ 3693
TD 3710 S/20 boph 2000 A
Comp. EPI 1880 bopd

COMPLETED

County Stafford State KansasSec. 7 (Blk. Twp.) 21 (Sur. Rge.) 14W Map No.Operator VickersWell No. 4 Farm FreyElev. Location NE NW NE

330 Ft. From N Line NE990 Ft. From W Line Quarter1st. Report NOV 22 1950

Completion

Remarks

Spudding Date 11-16-50Drlg. Data Frey PoolAnhy 876 8" @ 881 drlg. 2150

J. E. TYRA