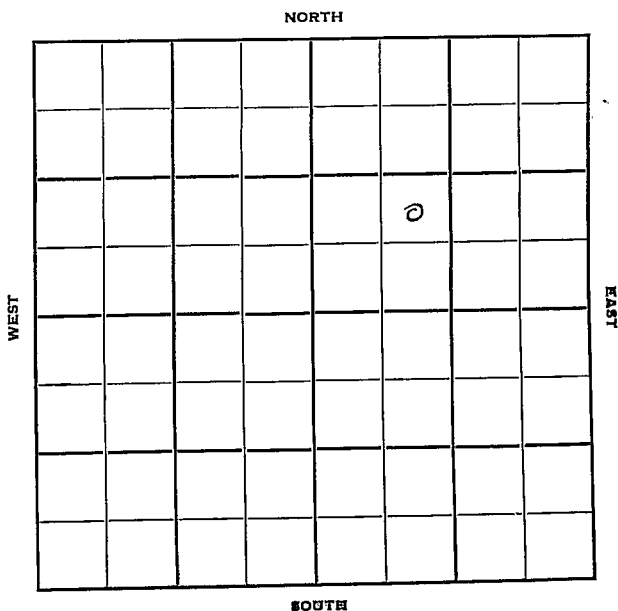


Section 7 Township 21 Range 14WWell No. #2 FreyCompany Vickers Petroleum

KANSAS Stafford
21 14-W

Sec. 7 Twp. R.

Well No. #2 Frey Farm

Vickers Petroleum Company

Jayhawk Drlg. Contractor

Frey


Ft. from N. Line

990 Ft. from S. Line

Ft. from E. Line

990 Ft. from W. Line

NE SW NE

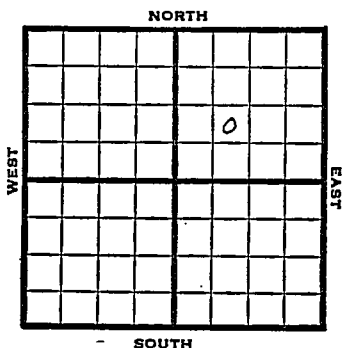

1950

Elev 1932

REPORT

10/18 MIR

11/29 Spud 10-18-50

Anhy 885

8" @ 890

Heeb 3265

Br lime 3367

Lans 3377

Viola 3628

Simp 3660

Arb 3709

DST 3710-26 TD

opn 15 min rec 520' fluid 400' oil

120' hocm

5" @ 3716

TD 3724

S/30 boph

2000 A

P/28 boph

Comp 3000 bopd

Completed

COMPLETED

County Stafford State Kansas
 Sec. 7 (Blk. 21 (Sur. 14W Map No.
 (Twp.) (Rge.)
 Operator Vickers Petroleum
 Well No. 2 Farm Frey
 Elev. Location NE SW NE

FIRST REPORT

990 Ft. From S Line NE

990 Ft. From W Line Quarter

1st. Report OCT 18 1950

Completion

Remarks

Jayhawk Drig. - Contr.


Spudding Date

Drig. Data

Frey Pool

M I R

County Stafford State Kansas
 Sec. 7 (Blk. 21 (Sur. 14W Map No.
 (Twp. (Rge.)
 Operator Vickers Petroleum
 Well No. 2 Farm Frey
 Elev. 1932 Location NE SW NE

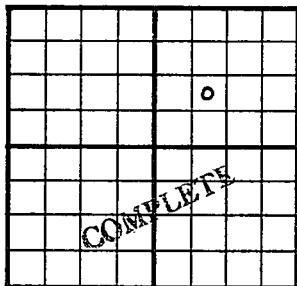

990 Ft. From S Line NE
990 Ft. From W Line Quarter
 Ist. Report
 Completion NOV 29 1950
 Remarks Frey Pool
Jayhawk Drlg. - Contr.
 Spudding Date 10-18-50

Drlg. Data Oil well TD 3724
Anhy 885 8" @ 890 Heeb. 3265
Br. line 3367 Lans. 3377 Viola. 3628
Sirp. 3660 Arb. 3709 DST 3710-26 TD
open 15 min. Rec. 520' fluid 400' oil
120' hoem 5" @ 3716 TD 3724
S/ 30 boph 2000 A P/ 28 boph
Comp. 3000 bopd :

J. E. TYRA