


Section 7 Township 21 Range 14W

Well No. #40. Opie

Company Sinclair O&G

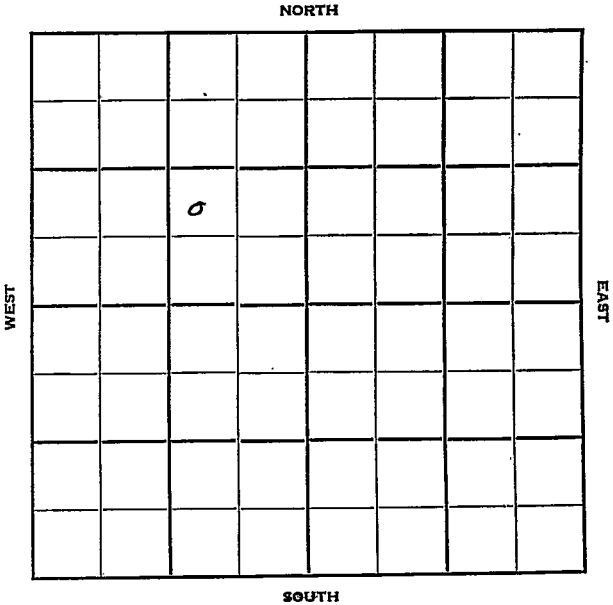

Sec. 7 Twp. 21 R. 14W

Well No. #4 O. Opie Farm

Sinclair Oil & Gas Company

Contractor


Ft. from N. Line

990' Ft. from S. Line

990' Ft. from E. Line

Ft. from W. Line

NW SE NW

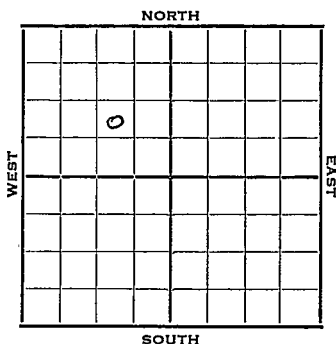

1952 Elev. 1931' REPORT

4/23 Spud 4-19-52
8" @ 913
Anhy 903
WOC

4/30 Drlg. 3140'
5/7 Spud 4-19-52
D&A TD 3800'
8" @ 913'
Anhy 903
Heeb. 3260
Doug. 3290
Lans. 3371
Cong. 3622
Simp. 3672
TD 3800' D&A

Top. 2955
Tor. 3271
Br Li 3359
SO 3492-96
Viola 3624
Arb. 3784

ABANDONED

County **Stafford** State **Kansas**Sec. **7** (Blk.) **21** (Sur.) **14W** Map No.Operator **Sinclair Oil & Gas**Well No. **4** Farm **0. Opie**Elev. Location **NW SE NW**

FIRST REPORT

990 Ft. From **S** Line **NW**990 Ft. From **E** Line Quarter1st. Report **APR 23 1952**

Completion


Remarks

Spudding Date **4-19-52**

Drlg. Data

8" @ 913 Anhy 903 WOC**J. G. McGEHEE**

County Stafford State Kansas
 Sec. 7 (Blk. 21 (Sur. 14W Map No.)
 Operator Sinclair Oil & Gas
 Well No. 4 Farm O. Opie
 Elev. 1931 Location NW SE NW

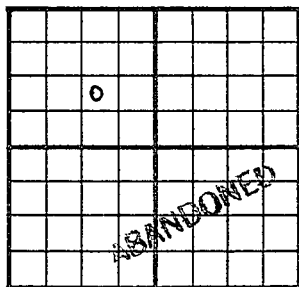

990 Ft. From S Line NW
 990 Ft. From E Line Quarter
 1st. Report
 Completion MAY 7 1952
 Remarks

Spudding Date 4-19-52

Drlg. Data D & A TD 3800

8" @ 913 Anhy 903 Top. 2955

Heeb. 3260 Tor. 3271 Doug. 3290

Br. lime 3359 Lans. 3371 SO 3492-96

Cong. 3622 Viola 3624 Simp. 3672

Arb. 3784 TD 3800

D & A

J. G. McGEHEE