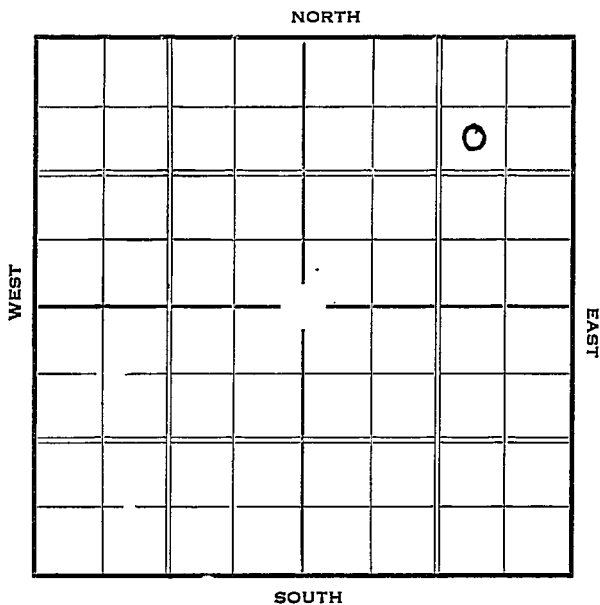



Rice

KANSAS

Section 7 Township 21 Range 7-WWell Number 3 - Patton "B"Company Atlantic

Sec. 7 Twp. 21 R. 7-WWell No. #3 Patton "B" FarmAtlantic Company990 Ft. from N. Line Ft. from S. Line990 Ft. from E. Line Ft. from W. Line

Elev. 1626

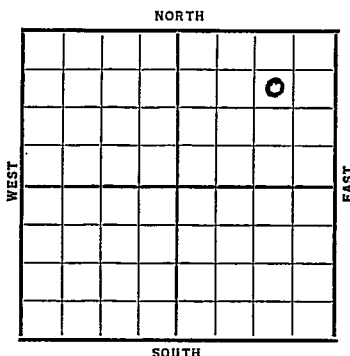

Date	REPORT
1937	
5/5	Location
5/14	R. R.
5/21	12" @ 107'. Drlg. 2000'.
5/28	K.C. 2815'. Drlg. 3190'.
6/4	7" @ 3327'. Cong. 3332'.
	Drlg. 3333'.
6/11	T.D. 3339' SW. SDO
6/19	" " " "
6/25	" " " "
7/2	Shot 30 qts. C.O.
7/9	" " " "
7/14	7" @ 3327'.
	Cong. 3332'.
	T.D. 3339'.
	Minimum well, 15 bbls. per
	day.
	COMPLETED

KANSAS

Map No. 49 Sec. 7 Twp. 21 R. 7^WWell No. 3 - Patton "B"Atlantic Company

Contractor

FIRST REPORT

SECTION PLAT

			0

990 Ft. from N. Line

_____ Ft. from S. Line

990 Ft. from E. Line

_____ Ft. from W. Line

Location ✓

Rig up _____

Drilling and Remarks:

RECORD

Cased _____ in., _____ ft.

Sand _____

Gas _____

Oil _____

Total Depth _____

PRODUCTION

1st 24 hrs. Nat. _____

1st 24 hrs. after shot _____

Gas _____ Cu. Ft.


Dry Hole _____

Abandoned _____

Date

MAY 5 - 1937

19

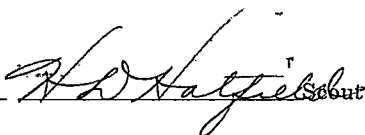
 H. D. Hatfield

Seal

Map No. _____ Sec. 7 Twp. 21 R. 7 ^WWell No. 3 - Patton "B"atlantic Company

Contractor _____

COMPLETED**SECTION PLAT**

			0

990 Ft. from N. Line

_____ Ft. from S. Line

990 Ft. from E. Line

_____ Ft. from W. Line

Location _____

Rig up _____

Drilling and Remarks:

*Minimum well**15 bbls per day***RECORD**Cased 7 in., 3327 ft.Sand Cong 3332

Gas _____

Oil _____

Total Depth 3339**PRODUCTION**

1st 24 hrs. Nat. _____

1st 24 hrs. after shot _____

Gas _____ Cu. Ft.

Dry Hole _____

Abandoned _____

Date

JUL 14 1937

19

H. D. 1937

Scout