Form 51-5M-12-36 Com'l


Rice

KANSAS

Section 7 Township 21 Range 7-W

Well Number 2 Patton "C"

Company Atlantic Ref.

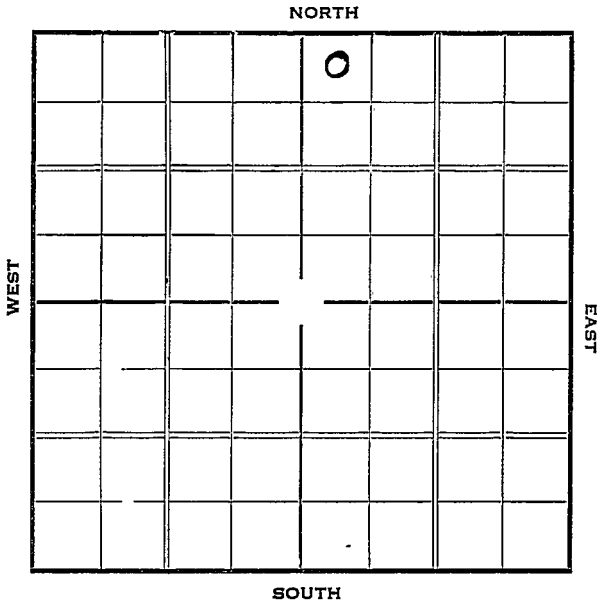

Form 252-A—5M—7-36—Palace KANSAS Rice

Sec. 7 Twp. 21 R. 7-W

Well No. #2 Patton "C" Farm


Atlantic Ref. Company

330 Ft. from N. Line

_____ Ft. from S. Line

_____ Ft. from E. Line

330 Ft. from W. Line

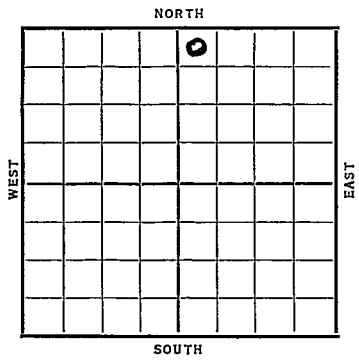

Date 1937	REPORT
3/10	Rig
3/18	12" @ 100 Drlg. 1400'.
3/25	Drlg. 3260'.
4/2	Conglomerate 3335'. 7" @ 3333'
	T.D. 3348' swabbing 20 bbls
	per hour.
4/7	Conglomerate 3335'.
	T. D. 3348'.
	Potential 644.
	COMPLETED

Form 26—1M Bks.—2-29 KANSAS


Map No. _____ Sec. 7 Twp. 21 R. 7W

Well No. 2. Patton "C"

Atlantic Ref. Company

_____ Contractor

SECTION PLAT

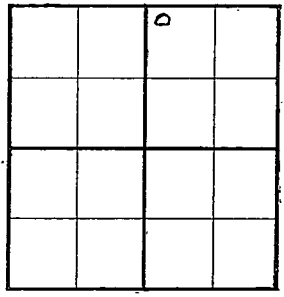

330 Ft. from N. Line

_____ Ft. from S. Line

_____ Ft. from E. Line

330 Ft. from W. Line

FIRST REPORT

Location _____

Rig up _____

Drilling and Remarks:

RLG

RECORD

Cased _____ in., _____ ft.

Sand _____

Gas _____

Oil _____

Total Depth _____

PRODUCTION

1st 24 hrs. Nat. _____

1st 24 hrs. after shot _____

Gas O Cu. Ft.

Dry Hole O

Abandoned _____

Date

MAR 10 1937 19

S. J. LEWIS Scout

Form 26—1M Bks. 2-29 KANSAS Rice


Map No. _____ Sec. 7 Twp. 21 R. 7W

Well No. 2 Patton "C"

Atlantic Ref. Company

_____ Contractor

SECTION PLAT

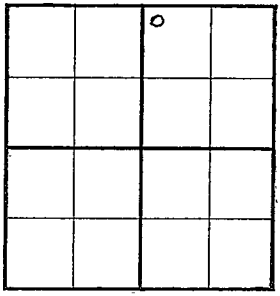

330 Ft. from N. Line

_____ Ft. from S. Line

_____ Ft. from E. Line

330 Ft. from W. Line

COMPLETED

Location _____

Rig up _____

Drilling and Remarks:

Conglomerate

3335

Potential

644

RECORD

Cased _____ in., _____ ft.

Sand _____

Gas _____

Oil _____

Total Depth 3348

PRODUCTION

1st 24 hrs. Nat. _____

1st 24 hrs. after shot _____

Gas _____ Cu. Ft.

Dry Hole _____

Abandoned _____

Date

APR 7 1937 19

S. J. LEWIS Scout