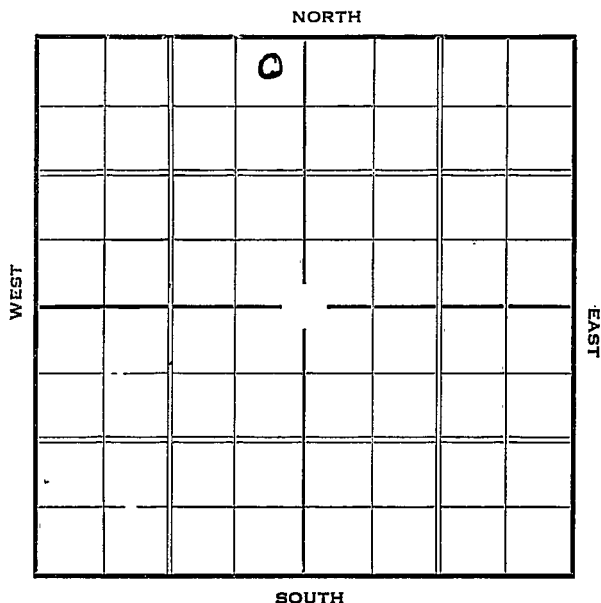


Section 7- Township 21 Range 7-WWell Number 1 Patton "D"Company Atlantic Refg.

KANSAS

Rice

Map No. _____ Sec. 7 Twp. 21 R. 7WWell No. 1 Patton "II"Atlantic Ry. Company

Contractor

SECTION PLAT

		0	

330 Ft. from N. Line

_____ Ft. from S. Line

330 Ft. from E. Line

_____ Ft. from W. Line

FIRST REPORT

Location _____

Rig up _____

Drilling and Remarks:

Rig

RECORD

Cased _____ in., _____ ft.

Sand _____

Gas _____

Oil _____

Total Depth _____

PRODUCTION

1st 24 hrs. Nat. _____

1st 24 hrs. after shot _____

Gas _____ Cu. Ft.

Dry Hole _____

Abandoned _____

Date

APR 7 1937 19

S. J. LEWIS

Scout

KANSASMap No. 49 Sec. 7 Twp. 21 R. 7 ^WWell No. 1-Patton "D"Atlantic Company

Contractor

COMPLETED**SECTION PLAT**

		0		

330 Ft. from N. Line1 Ft. from S. Line330 Ft. from E. Line Ft. from W. LineLocation Rig up

Drilling and Remarks:

POT-Flowed - 602/24 hrs**RECORD**Cased 7 in., 3328 ft.Sand CHAT. 3339Gas Oil Total Depth 3346**PRODUCTION**1st 24 hrs. Nat: 1st 24 hrs. after shot Gas Cu. Ft.Dry Hole Abandoned

Date

MAY 12 1937H. D. Hatfield Scout