

KANSAS


Rice

FORM 51 5M 1-42 PETROL

Section 7 Township 21 Range 8-W

Well No. #1 Blackhall

Company Falcon Seaboard etal

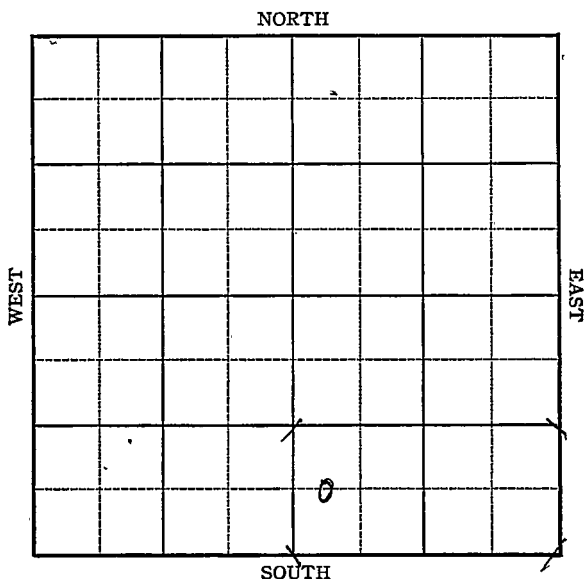


KANSAS

Rice

Sec. 7 Twp. 21 R. 8-WWell No. #1 Blackhall FarmFalcon Seaboard etal Company

Wildcat

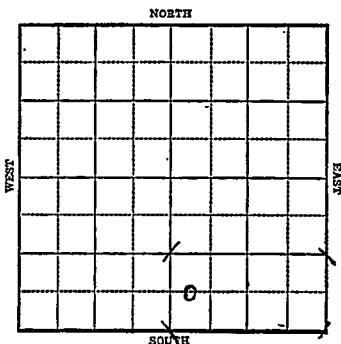 Ft. from N. Line660 Ft. from S. Line Ft. from E. Line330 Ft. from W. LineElev. 1657

1943

R E P O R T

7/21 Derrick

7/28 "

8/4 "

8/11 10" @ 180'
Drlg. 1326'8/18 Topeka 2530
Lans 2965
Drlg. 3085'8/25 Viola 3495
Simp 3525
T.D. 2578FSG
9/1 Arb 3607
T.D. 3640'**ABANDONED**

Rice


KANSAS

Map No. 49 Sec. 7 Twp. 21 R. 8WWell No. 1 BlackhallFalcon Seaboard etal CompanyFIRST REPORT Contractor

C W L SW SE

 Ft. from N. Line660 Ft. from S. Line Ft. from E. Line330 Ft. from W. Line

SECTION PLAT

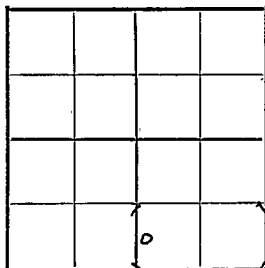

WILD CAT

Location Rig up

Drilling and Remarks:

Derrick

RECORD

Cased in., ft.Sand Gas Oil Total Depth

PRODUCTION

1st 24 hrs. Nat. 1st 24 hrs. after shot Gas Cu. Ft.Dry Hole Abandoned

Date

JUL 21 1943

19

S. J. LEWIS Scout

KANSASMap No. 42 Sec. 7 Twp. 21 R. 8WWell No. 1 BlackhallFalcon Seaboard etal CompanyABANDONED Contractor


C W L SW SE

SECTION PLAT

Ft. from N. Line

660 Ft. from S. Line

Ft. from E. Line

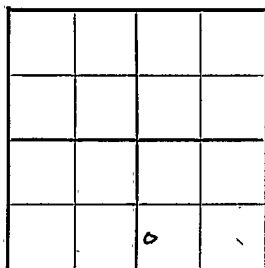330 Ft. from W. LineWildcat

Location _____

Rig up _____

Drilling and Remarks:

Cr 83607

RECORD

Cased _____ in., _____ ft.

Sand _____

Gas _____

Oil _____

Total Depth 3640

PRODUCTION

1st 24 hrs. Nat. _____

1st 24 hrs. after shot _____

Gas _____ Cu. Ft.

Dry Hole _____

Abandoned _____

Date

SEP 1 1943 19 S. J. LEWIS Scout