




Map No. KANSAS Sec. 7 Twp. 21 R. 10<sup>w</sup>

Well No. 1- Miller Farm

Boucher Coal Company

NORTH

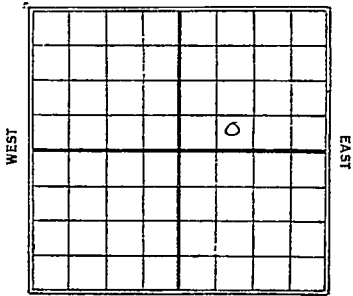

\_\_\_\_\_ Ft. from N. Line

330 Ft. from S. Line

\_\_\_\_\_ Ft. from E. Line

990 Ft. from W. Line

1930

Date

REPORT

Date	REPORT
6/25	Loc
7/2	Rig
7/9	Rigging up
7/16	Shot down
7/23	—
7/30	—
8/6	Spud
8/13	45" 625'
8/20	dry 1350'
8/27	" 1770'
9/3	S.D. 1770'
9/10	—
9/17	dry 1880'
9/24	U10 10" 1916'
10/1	2 7/8 W 2000-10
	T.D. 2020 2 1/2" 10"
10/8	10" 2119'
	dry 2150'
10/15	U10 8" 2252'
10/24	dry 2475'
10/29	U10 8" 2770'
11/5	—

11/12 - U/R 8" - 2800'  
11/19 - Dry 2875  
11/25 - " 2920'  
12/2 - HFW 3330-35  
T.D. 3376' U/R 6"  
12/10 - Dry 3383  
12/17 - " 3417  
12/24 TD. 3417  
dry & abandon

Map No. 46 **KANSAS** Sec. 7 Twp. 21 R. 10W  
 Well No. Miller

Boucher & Co. Company  
 Contractor

**SECTION PLAT**

..... Ft. from N. Line  
300 Ft. from S. Line  
 ..... Ft. from E. Line  
990 Ft. from W. Line


**FIRST REPORTS**

Location.....  
 Rig up.....  
 Drilling and Remarks:

**RECORD**

Cased..... in., ..... ft.  
 Sand.....  
 Gas.....  
 Oil.....  
 Total Depth.....


**PRODUCTION**

1st 24 hrs. Nat.....  
 1st 24 hrs. after shot.....  
 Gas..... Cu. Ft.  
 Dry Hole.....  
 Abandoned.....

Date

JUN 25 1930

S. J. LEWIS Scout

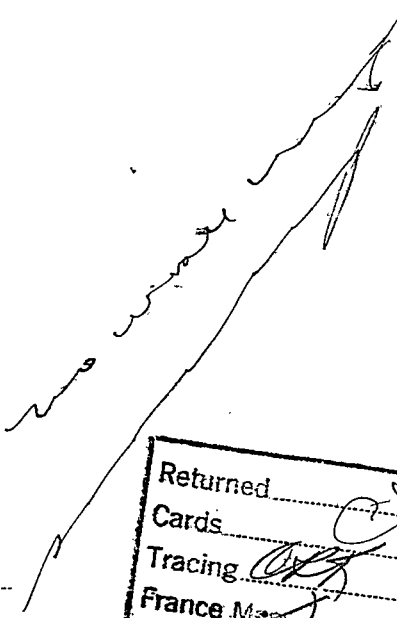

Returned	.....
Cards	.....
Tracing	.....
France Map	.....
Scarborough Map	.....
Moody Map	.....
Scarborough Plat B	.....
Moody Plat Book	.....

Map No. KANSAS Sec. 7 Twp. 21 R. 10 W

46  
Well No. Miller

Boucher & Co Company

Contractor

**SECTION PLAT**

..... Ft. from N. Line

330 Ft. from S. Line

..... Ft. from E. Line

990 Ft. from W. Line

		0	

**ABANDONED**

Location.....

Rig up.....

Drilling and Remarks:

**RECORD**

Cased..... in., ..... ft.

Sand.....

Gas.....

Oil.....

Total Depth. 3417

**PRODUCTION**

1st 24 hrs. Nat.....

1st 24 hrs. after shot.....

Gas..... Cu. Ft.

Dry Hole.....

Abandoned.....

Date

DEC 23 1930

S. J. LEWIS Scout

*no more*

Returned	.....
Cards	..... <i>RP</i>
Tracing	..... <i>CPK</i>
France Map	..... <i>X</i>
Scarborough Map	..... <i>X</i>
Moody Map	..... <i>X</i>
Scarborough Flat Sheet	.....
.....	.....