


Stafford KANSAS

SECTION 7 TOWNSHIP 21S RANGE 11W

WELL NO. #2 Schlochtermeier

COMPANY Duke Drlg. Co.

NORTH $\frac{E}{2}$
 $\frac{N}{2}$ $\frac{E}{2}$ SE

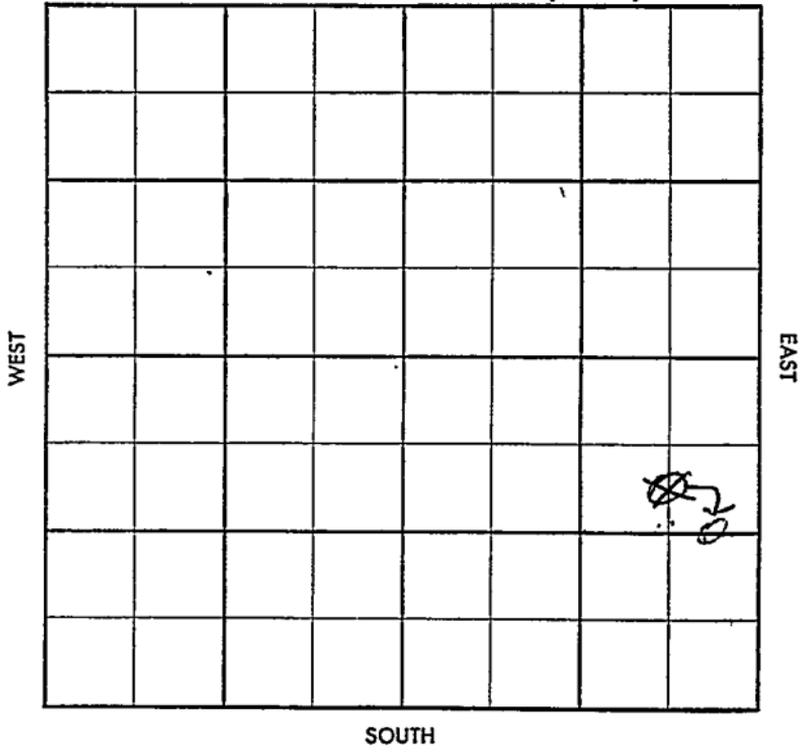

~~Twp.~~ ~~Pool~~
~~Co.~~ ~~Facst.~~

S-513-B

County Stafford Elev. _____
 Sec. 7 Twp. 21 Rge. 11W
 Company Duke Drlg. Co.
 Farm Name Schlochtermeier No. 2

TOPS	DEPTH	LOG	DATUM
Anh.	567		
Tp.			
H.			
Tr.			
Dg.			
B.L.			
L.			
K.C.			
B.K.C.			
Ce.			
C.			
M.			
M.			
K.			
Mz.			
Mq.			
V.			
S.			
S.			
A.			
R.			
Pf.			
G.			
T.D.			

Loc. in Sec. _____
N/2 E/2 SE

Geol. _____
 Contr. _____
Co. Tools
 Pool _____
Sandago

JUN 3 1958
FIRST REPORT

Date Comm. 6/1/58
8" 258 Drlg. 1000

Co. _____
Lse. _____
No. _____
Sec. _____
T. _____
R. _____

Tw. 1 Post 1

CORRECTION ~~X~~ Facet ~~X~~

S-513-B

County Stafford Elev. 18110 F 18148 B
 Sec. 7 Twp. 21 Rge. 11W
 Company Duke Drlg. Co.
 Farm Name Schlochtermeyer No. 2

TOPS	DEPTH	LOG	DATUM
Anh.	567		
Tp.			
H. <u>3012</u>	<u>3008</u>		
Tr.			
Dg.			
B.L. <u>3136</u>	<u>3134</u>		
L. <u>3153</u>	<u>3148</u>		
K.C.			
B.K.C.			
Ce.			
C. <u>3368</u>	<u>3386</u>		
M.			
M.			
K.			
Mz.			
Mq.			
V.			
S. <u>sd</u>	<u>3401</u>		
S. <u>sh</u>	<u>3407</u>		
A. <u>3432</u>	<u>3412</u>		
R.			
Pf.			
G.			
T.D. <u>3485</u>	<u>3493</u>		

Loc. in Sec. N/2 E/2 SE
E/2

Geol. _____
 Contr. _____
 Co. Tools _____
 Pool Sandago

COMPLETE
 JUL 30 '58

Date Comm. 6/1/58
 8" 258 Drlg. 1000 JUN 11 '58 DST 3283-98
 5/4" 5" M BHPD Ø 3390 JUN 18 '58 DST
 3437-53. 90" 270' oil BHPD 1020/20
 5/4" 3485 M LCT JUN 25 '58 JUL 2 '58
 CO 2908 JUL 9 '58 JUL 16 '58 DST
 3452-75 90" 243 MCO 3090 Form
 W BHP 1005 5" 3484 on pump
 JUL 23 '58 24" / 3444-48 B 3390 ph + 4
 3 hrs (1/2) 5.80 BF 3090 W 2 hrs.

Co.
Lse.
No.
Sec.
T.
R.

FU 724' 011 884' W NT

FU 1800' fld 12hrs \$ 78 FPH

3090 W 2hrs POP P JUL 30 '58

\$ 530 2B WPH NT POP

P 25B OPD + 2B W PD

\$