

Stafford


KANSAS

SECTION 7 TOWNSHIP 21 RANGE 11W

WELL NO. #2 Scholtermeier

COMPANY F.D. Asbury

NORTH *NE SE NE NE*

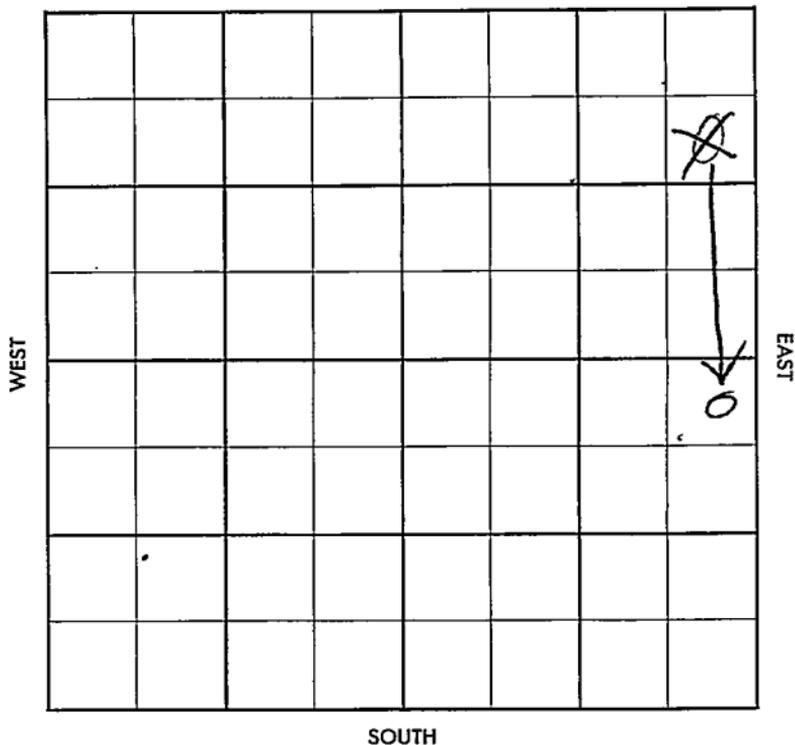

County Stafford Elev. _____
 Sec. 7 Twp. 21 Rge. 11W
 Company F. D. Ashbury
 FarmName Schochtermeier No. 2

TOPS	DEPTH	LOG	DATUM
Anh.			
Tp.			
H.			
Tr.			
Dg.			
Bl.			
L.			
K.C.			
B.K.C.			
Ce.			
C.			
M.			
M.			
K.			
Mz.			
Ma.			
V.			
S.			
S.			
A.			
R.			
Pe.			
G.			
T.D.			

Loc. in Sec. SE NE NE
 Geol. _____
 Contr. Duke Drlg.
 Pool Kesselman

JUL 3 '57
 FIRST REPORT

Date Comm. 6-28-57
8" @ 266/160 drlg. 1170

~~13~~

Co.
Lse.
No.
Sec.
T.
R.

CORRECTION

FORM 513 SUNRAY

County Stafford Elev. 1813 KB
 Sec. 7 Twp. 21 Rgs. 11W
 Company F. D. Asbury
 Farm Name Scholtermeier No. 2

TOPS	DEPTH	LOG	DATUM	Loc. in Sec.
Anh.	592			SE NE SE
TP.				
H.	3012			
Tr.				
Dg.				
Bl.	3138			
L.	3155			
K.C.				Geol.
B.K.C.				Contr.
Ce.				Duke Drlg.
C.				
M.				Pool
M.				Kesselman
K.				
Mz.				
Mo.				
V.				
S.				AUG 7 '57
S.				
A.	3424			
R.				
PE.				
G.				COMPLETE
T.D.	3434			

Date Comm. 6-28-57

8" @ 266/160 drlg. 1/10 JUL 10 '57 DST
 3282-3307 1hr 300 GIP
 rec 70' GCM FP 0-0 BHP 0
 # 3410 JUL 17 '57 DST 3426-34 45"
 540' GIP rec 160' Mdy 9554 oil
 FP 0-68 975/20 5 1/2 3428 JUL 21 '57
 Co 3434 A \$ 3 Boph nolw
 POP JUL 31 '57 AUG 8 '57 P. 5 1/2 Boph
 nolwt decreased to 23 Bopd nolw
 comp. est 25 Bopd nolw 9mas 38°