


Stafford


KANSAS

SECTION 7 TOWNSHIP 21S RANGE 11W

WELL NO. #2 Schlochtermeier

COMPANY Fred Asbury

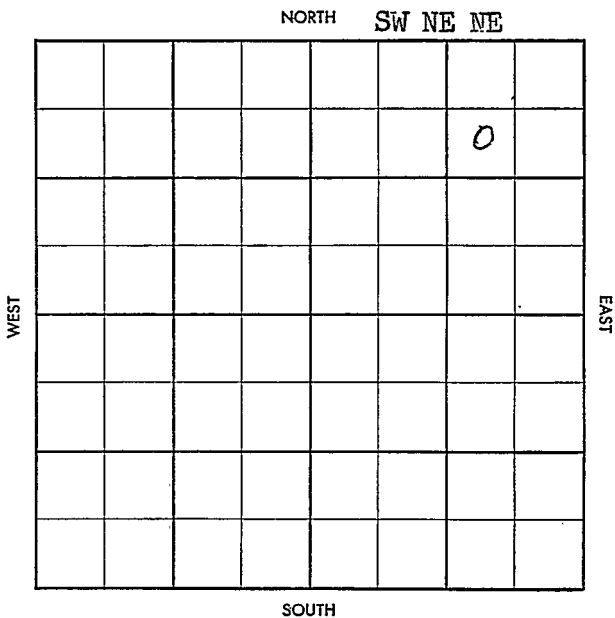

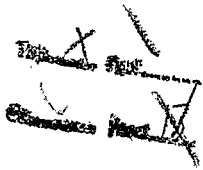

County Stafford Elev. _____
 Sec. 7 Twp. 21 Rge. 11W
 Company Fred Asbury
 Farm Name Schlochtermeyer No. 2

TOPS	DEPTH	LOG	DATUM
Anh.			
Tp.			
H.			
Tr.			
Dg.			
B.L.			
L.			
K.C.			
B.K.C.			
Ce.			
C.			
M.			
M.			
K.			
Mz.			
Mq.			
V.			
S.			
S.			
A.			
R.			
Pf.			
G.			
T.D.			

Loc. in Sec. SW NE NE

Geol. _____

Contr. _____

Duke Drig.

Pool _____

Kesselman

MAY 21 58
FIRST REPORT

Date Comm. 5-17-58
8" @ 251/150

Co.
Lse.
No.
Sec.
T.
R.

Lwp. Pool
 Co. Facet

5-513-B

County Stafford Elev. 1815 of 1818 RB
 Sec. 7 Twp. 21 Rge. 11W
 Company Ered Asbury
 Farm Name Schlöchtermeier No. 2

TOPS	DEPTH	LOG	DATUM
Ann.			
Tr.			
H.	<u>3012</u>		
Da.			
B.C.	<u>3126</u>		
L.	<u>3157</u>		
K.C.			
B.K.C.			
Ce.			
C.			
M.			
M.			
K.			
Mz.			
Mq.			
V.			
S.			
S.			
A.	<u>3439</u>		
R.			
Pf.			
G.			
T.D.	<u>3454</u>		

Loc. in Sec. SW NE NE
1150 FE
 Geol. _____
 Contr. _____
Duke Drlg.
 Pool _____
Kesselman
 COMPLETE
 JUL 2 '58

Date Comin. 5-17-58
8" @ 251/150 MAY 28 '58 @ 3235 JUN 3 '58 DS
3440 - 54 1hr gray oil
3454 50 JUN 11 '58 JUN 18 '58
JUN 25 '58 pumping JUL 2 '58 4 1/2 3440 CO
3454 @ 7 1/2 BOPH NW 3 hrs
3 @ 10 BOPH NW NT POP
P 15 BOPH NW

Co. No. Sec. T. R.