

KANSAS


Stafford

Form 51-5M-11-38-Palace

Section 7 Township 21 Range 11-W

Well No. #1 Schlochtermeyer

Company Virginia Drilling

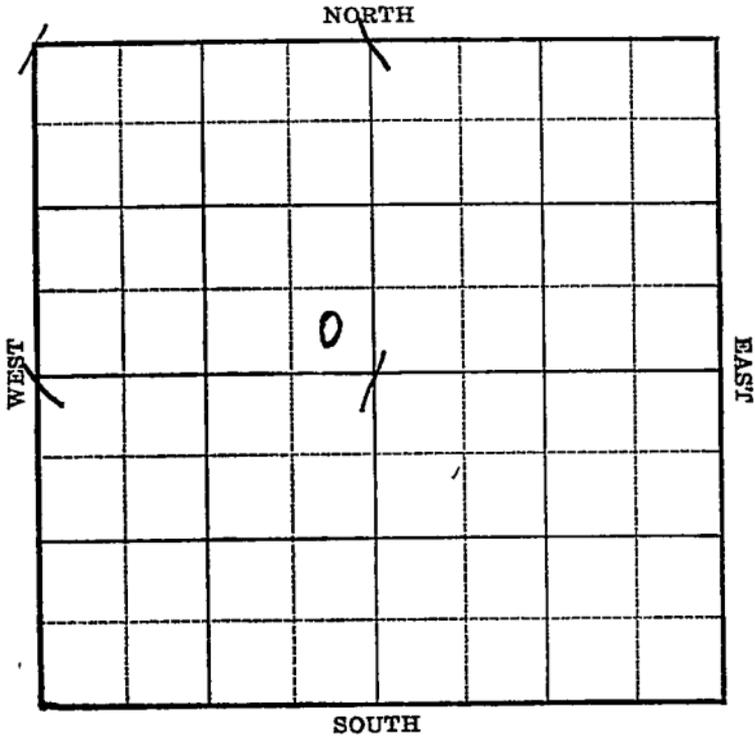

Sec. 7 Twp. 21 R. 11-W

Well No. #1 Schläcktermeyer Farm

Virginia Drilling Company


\_\_\_\_\_ Ft. from N. Line

330 Ft. from S. Line

330 Ft. from E. Line

\_\_\_\_\_ Ft. from W. Line

Elev. 1813

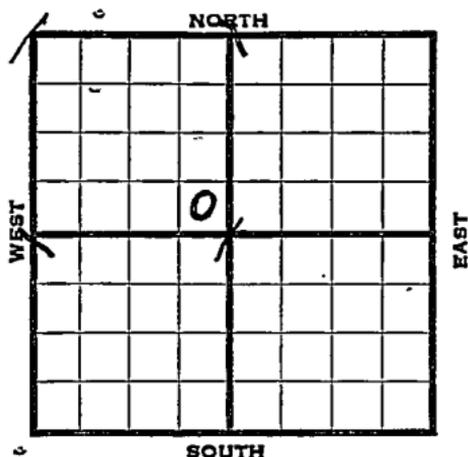

1938	REPORT
12/7	Location
12/15	R. R.
12/23	R U R
12/30	10" - 247'. WOC.
1939	
1/6	" " "
1/13	" " "
1/20	Anhy 575'. Drlg. 1350'.
1/27	Fort. Riley 1700'. Drlg. -2675'.
2/3	Topeka 2765'. Lans. 3175'. Drlg. 3230'.
2/10	Cong. 3415'. S. O. 3452-55 in sdy gr. shale.
2/17	7" - 3457' WOC.
2/23	Drilled plug. 600' fluid in 6 hours. Deepened to 3369' T.D. C. O.
3/3	" "
3/10	Testing.
	<b>OVER</b>

1939

3/17 500 acid. Pump 5 oil per hour.

3/24 800 acid. Swab 2 oil per hr.  
Drig. 3415'

3/29 7" - 3457'  
Arb. 3457'  
T. D. 3580'  
1500' water.

ABANDONED.

Stafford **KANSAS**

Map No. 46 Sec. 7 Twp. 21 R. 11W

Well No. 1 Schlocktermeyer

Virginia Drlg. Company

**FIRST REPORT**

Contractor

*STano. F. O.*  
**SECTION PLAT**


**SE NW**

\_\_\_\_\_ Ft. from N. Line

330 Ft. from S. Line

330 Ft. from E. Line

\_\_\_\_\_ Ft. from W. Line

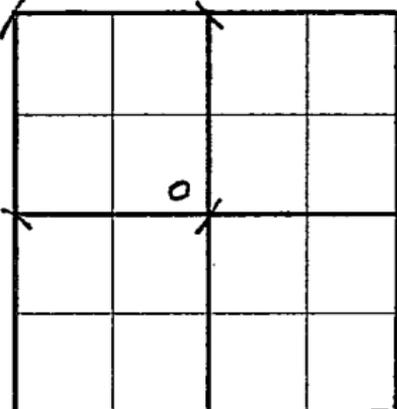

Location X

Rig up \_\_\_\_\_

Drilling and Remarks:

**RECORD**

Cased \_\_\_\_\_ in., \_\_\_\_\_ ft.

Sand \_\_\_\_\_

Gas \_\_\_\_\_

Oil \_\_\_\_\_

Total Depth \_\_\_\_\_

**PRODUCTION**

1st 24 hrs. Nat. \_\_\_\_\_

1st 24 hrs. after shot \_\_\_\_\_

Gas \_\_\_\_\_ Cu. Ft.

Dry Hole \_\_\_\_\_

Abandoned \_\_\_\_\_

Date

DEC 7 - 1938 19

H. D. Hatfield Scout

Stafford **KANSAS**Map No. 46 Sec. 7 Twp. 21 R. 11WWell No. 1 SchlocktermeyerVirginia Drlg. Company

Contractor

**ABANDONED****SE NW**         Ft. from N. Line330 Ft. from S. Line330 Ft. from E. Line         Ft. from W. Line**WILDCAT****SECTION PLAT**

	0		

Location                                 Rig up                                 

Drilling and Remarks:

1500' wtrDVA**RECORD**Cased 7 in., 3457 ft.Sand Arb 3457Gas                                 Oil                                 Total Depth 3580**PRODUCTION**1st 24 hrs. Nat.                         1st 24 hrs. after shot                         Gas                                  Cu. Ft.Dry Hole                                 Abandoned                                 

Date

MAR 29 193919H. D. Hatfield Scout