


KANSAS Stafford

FORM 51 IOM 12-46 PETROL

Section 7 Township 21 Range 11W

Well No. 2 Schlochtermayer

Company Magnolia

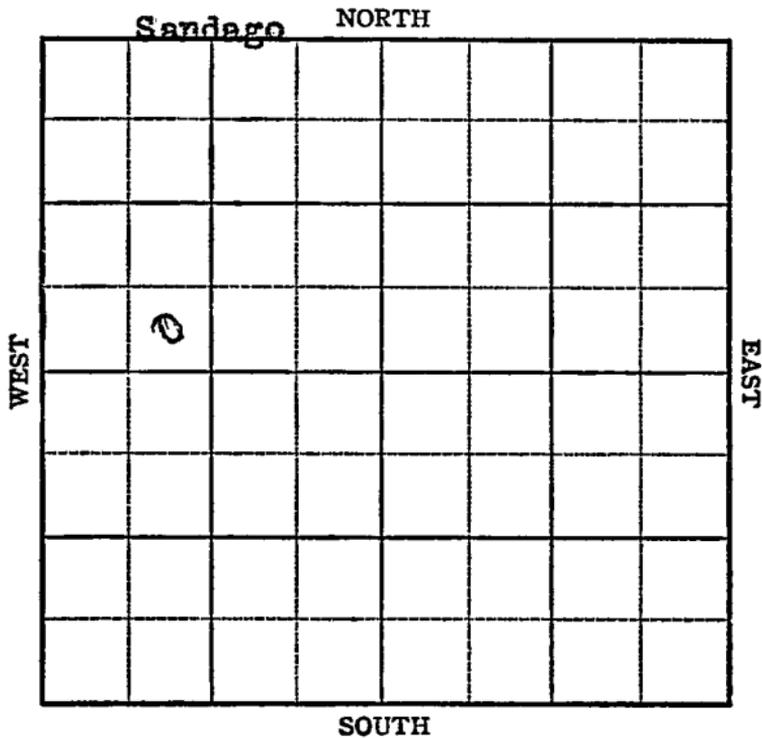



7

21

11W.

Sec. _____ Twp. _____ R. _____

Well No. #2 Schlochtermeyer Farm

Magnolia Company

Sandago


_____ Ft. from N. Line

330 _____ Ft. from S. Line

_____ Ft. from E. Line

990 _____ Ft. from W. Line

SE SW NW

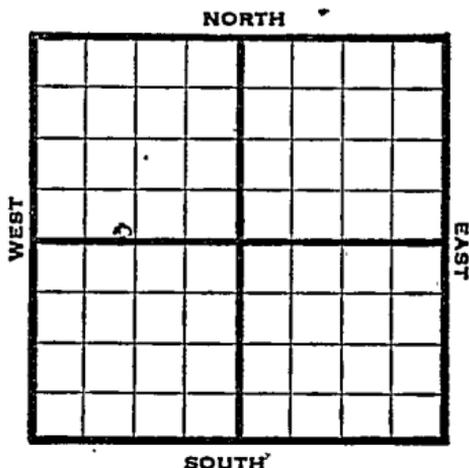

1947

Elev. 1811 REPORT

9/10

Location

9/17

8" @ 290'
WOC

9/24

Drlg. 2975'

10/1

Lansing 3169'
Simpson 3414'
Arbuckle 3447'
TD 3450' >
5" @ 3499
RUST

10/8

TD 3458'
500' oil
1000 Acid

10/15

Arbuckle 3447
5" @ 3449
Pump 89 Pot
TD 3459
Gravity 37

COMPLETED

Map No. _____ Sec. 7 Twp. 21 R. 11W

Well No. 2 Schlochtermeyer

Magnolia Company

~~FIRST REPORT~~ Contractor

SE SW NW


SECTION PLAT

_____ Ft. from N. Line

330 Ft. from S. Line

_____ Ft. from E. Line

990 Ft. from W. Line

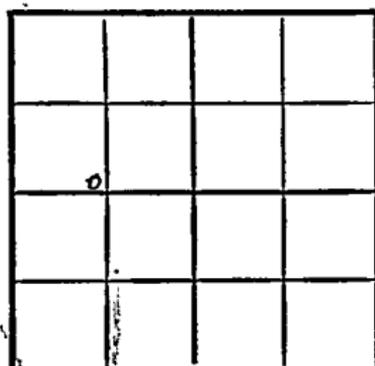

Stafford County

Location X

Rig up _____

Drilling and Remarks:

RECORD

Cased _____ in., _____ ft.

Sand _____

Gas _____

Oil _____

Total Depth _____

PRODUCTION

1st 24 hrs. Nat. _____

1st 24 hrs. after shot _____

Gas _____ Cu. Ft.

Dry Hole _____

Abandoned _____

Date

SEP 10 1947

19

S. I. LEWIS Scout

