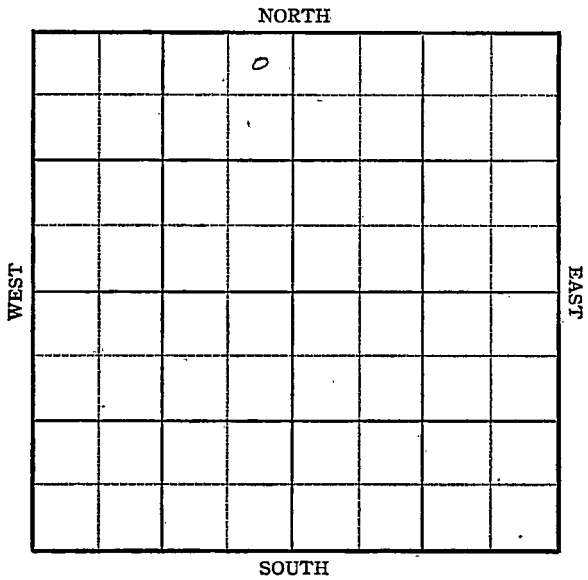


KANSAS

Stafford

FORM 51 5M PETROL

Section 7 Township 21 Range 11WWell No. 1 SchlochtermeyerCompany Magnolia

KANSAS

Stafford

Sec. 7 Twp. 21 R. 11-W

Well No. #1 Schlochtermeyer Farm

Magnolia Company


330 Ft. from N. Line

 Ft. from S. Line

330 Ft. from E. Line

 Ft. from W. Line

NE NW

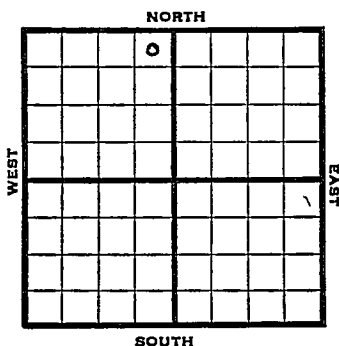

1945

Elev. 1822

REPORT

10/3 8" @ 310' WOC

10/10 Drlg. 2805'

10/17 Lens. 3169

Arb. 3472

TD 3498'

ABANDONED


Kansas Pool Name SniderMap No. 46 Sec. 7 Twp. 21 R. 11WWell No. 1 SchlochtermeyerMagnolia Company

FIRST REPORT

Contractor

NE NW

SECTION PLAT

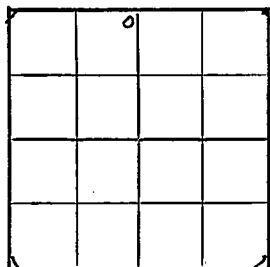330 Ft. from N. Line Ft. from S. Line330 Ft. from E. Line Ft. from W. LineStafford CountyLocation Rig up

Drilling and Remarks:

8"-310 WOC

RECORD

Cased in., ft.Sand Gas Oil Total Depth

PRODUCTION

1st 24 hrs. Nat. 1st 24 hrs. after shot Gas Cu. Ft.Dry Hole Abandoned

Date

OCT 3 1945 19S. L. LEWIS Scout

KANSAS Kansas

Pool Name WildcatMap No. 46 Sec. 7 Twp. 21 R. 11WWell No. 1 SchlochtermeyerMagnolia

Company

ABANDONED

Contractor


NE NW

E 1822
SECTION PLAT330 Ft. from N. Line

Ft. from S. Line

330 Ft. from E. Line

Ft. from W. Line

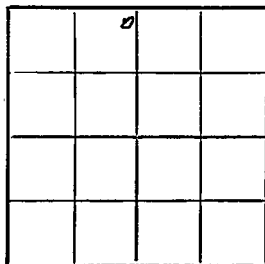Stafford County

Location

Rig up

Drilling and Remarks:

Lane 3169Per 3472

RECORD

Cased _____ in., _____ ft.

Sand _____

Gas _____

Oil _____

Total Depth 8498

PRODUCTION

1st 24 hrs. Nat. _____

1st 24 hrs. after shot _____

Gas _____ Cu. Ft.

Dry Hole _____

Abandoned _____

Date

OCT 17 1945 19S. J. LEWIS

Scout