


Section 7 Township 21 Range 11W

Well No. 1 Schlochtermayer "B"

Company Magnolia

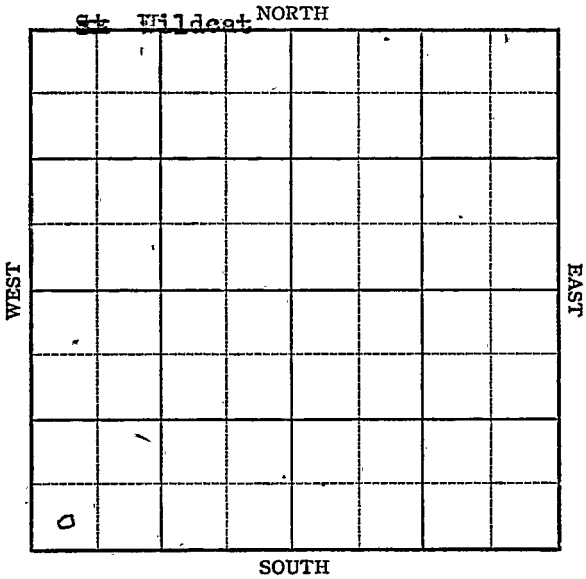

KANSAS

Stafford

Sec. 7 Twp. 21 R. 11W

Well No. #1 Schlochtermeyer "B" Farm

Magnolia Company
Wildcat


Ft. from N. Line

330 Ft. from S. Line

Ft. from E. Line

330 Ft. from W. Line

SW/c

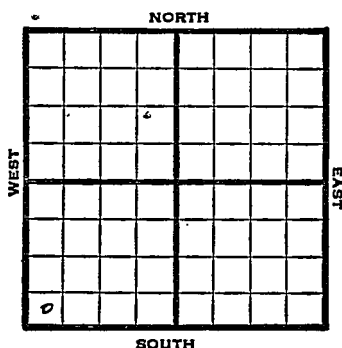

Elev. 1815' REPORT

1947

7/23 Location

7/29 8" @ 300'
Drlg. 1525'

8/6 Lansing 3159'
Drlg 3257'

8/13 Arbuckle 3468'
3471 TD
5" @ 3469
RUST

8/20 TD 3504'
6000 acid

8/27 "

9/3 "

9/10 2000 acid swb 4 bbls oil &
34 W 16 hrs PB

9/17 PB 3458'
36 shots. 3233-45'
36 shots. 3248-56' - 1000 acid,
Pump 18 bbls. oil PH 18 hrs.

OVER

1947

9/24

Arb. 3468'
5" @ 3469'
Lans. 3159'
Perf. Lans.
1000 acid
Pump 438 Pot
3950 Gr.
TD 3504'

COMPLETED

Kansas

Map No. _____ Sec. 7 Twp. 21 R. 11WWell No. 1 Schlochtermeyer "B"

_____ Magnolia _____ Company

_____ FIRST REPORT _____ Contractor

SW/C

SECTION PLAT

_____ Ft. from N. Line

330 Ft. from S. Line

_____ Ft. from E. Line

330 Ft. from W. Line

Stafford County

Location x

Rig up _____

Drilling and Remarks:

RECORD

Cased _____ in., _____ ft.

Sand _____

Gas _____

Oil _____

Total Depth _____

PRODUCTION

1st 24 hrs. Nat. _____

1st 24 hrs. after shot _____

Gas _____ Cu. Ft.

Dry Hole _____

Abandoned _____

Date

JUL 23 1947

19

S. J. LEWIS

Scout

Misc. Small Maps _____
Cards Ref _____
Tracing _____
France Map _____
Scarborough Map _____
Pierce Map _____
Geological Dept. _____
Pierce Flat Book _____

Map No. 46 Sec. 7 Twp. 21 R. 11W

Well No. 1 Schlochtermeyer "B"


Magnolia Company

COMPLETE

Contractor

SW/C

51,1875.
SECTION PLAT

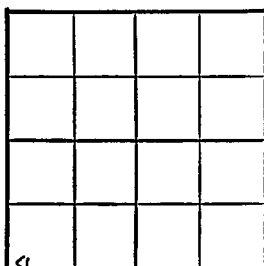

 Ft. from N. Line

330 Ft. from S. Line

 Ft. from E. Line

330 Ft. from W. Line

Stafford County

Location

Rig up

Drilling and Remarks:

Ar 83465
5' @ 3465
have 8159
Ref have.
1000000
Pump 438 1/2 ft.
890 ft

RECORD

Cased in., ft.

Sand

Gas

Oil

Total Depth 3504

PRODUCTION

1st 24 hrs. Nat.

1st 24 hrs. after shot

Gas Cu. Ft.

Dry Hole

Abandoned

Date

SEP 24 1947

19

S. J. LEWIS

Scout

Wm

Misc. Small Maps	<i>JK</i>
Cards	<i>JK</i>
Tracing	<i>JK</i>
France Map	<i>JK</i>
Scarborough Map	<i>JK</i>
Pierce Map	<i>JK</i>
Geological Dept.	<i>JK</i>
Pierce Plat Don't	<i>JK</i>