

KANSAS

Stafford

Section 7 Township 21 Range 12W

Well No. 1 Nolte

Company Phillips & Hanson

James

NORTH

0							

WEST

EAST

SOUTH

KANSAS

Stafford

Sec. 7 Twp. 21 R. 12W ✓

Well No. #1 Nolte Farm _____

Phillips & Hanson Company

James Pool


_____ Ft. from N. Line

330'

_____ Ft. from S. Line

_____ Ft. from E. Line

330' Ft. from W. Line

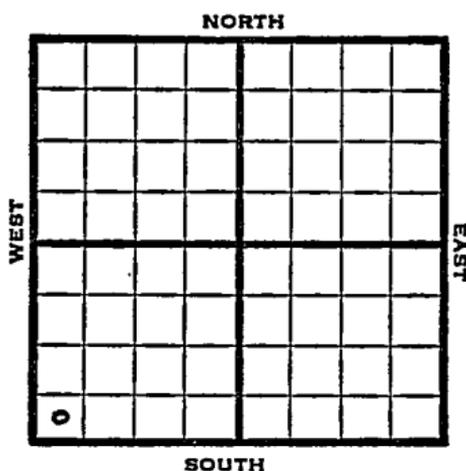

SW/c

1949

Elev 1861'

REPORT

4/13

Location

4/20

8" @ 350'

Drig. 2055'

4/27

Lans. 3267'

Simp 3533'

Arb. 3538'-44'

TD 3544'

5" @ 3540'

"

5/4

TD 3566'

5/11

Arb. 3538'

5" @ 3540'

Aband.

ABANDONED

Kansas

Map No. _____ Sec. 7 Twp. 21 R. 12WWell No. 1 NoltePhillips & Hanson Company

FIRST REPORT

Contractor

SW/C

SECTION PLAT


_____ Ft. from N. Line

330 Ft. from S. Line

_____ Ft. from E. Line

330 Ft. from W. Line

Stafford County

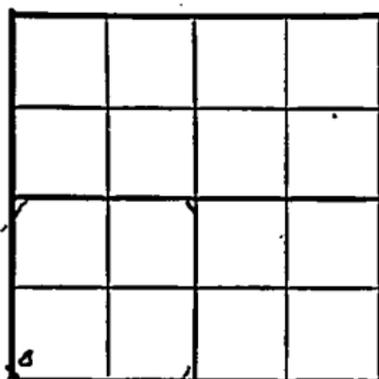Location X

Rig up _____

Drilling and Remarks:

RECORD

Cased _____ in., _____ ft.

Sand _____

Gas _____

Oil _____

Total Depth _____

PRODUCTION

1st 24 hrs. Nat. _____

1st 24 hrs. after shot _____

Gas _____ Cu. Ft.

Dry Hole _____

Abandoned _____

Date

APR 13 1949

19

S. J. LEWIS

Scout

Map No. K46 Sec. 7 Twp. 21 R. 12W

Well No. 1 Nolte

Phillips & Hanson Company

ABANDONED Contractor

SW/C

E11861
SECTION PLAT

_____ Ft. from N. Line

330 Ft. from S. Line

_____ Ft. from E. Line

330 Ft. from W. Line

Stafford County

Location _____

Rig up _____

Drilling and Remarks:

CR X 3038
5" 03540

RECORD

Cased _____ in., _____ ft.

Sand _____

Gas _____

Oil _____

Total Depth 3566

PRODUCTION

1st 24 hrs. Nat. _____

1st 24 hrs. after shot _____

Gas _____ Cu. Ft.

Dry Hole _____

Abandoned _____

Date

MAY 11 1949 19

S. J. LEWIS Scout