


Section 15 Township 21 Range 8W

Well No. #1 Bell

Company Pickerall

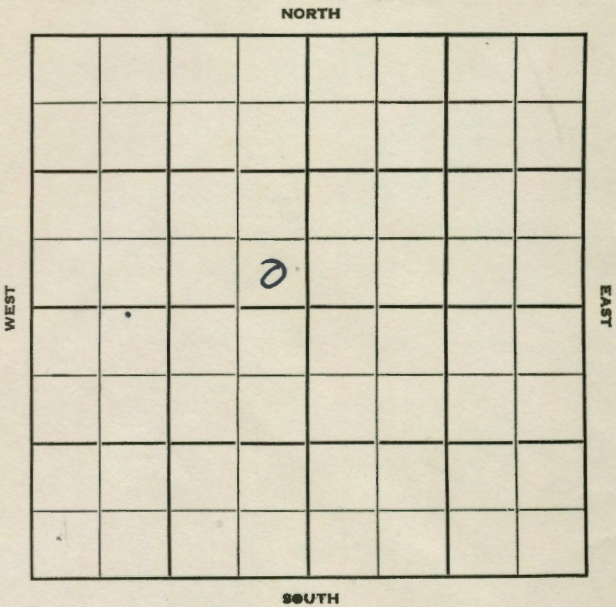

Sec. 15 Twp. 21 R. 8W

Well No. #1 Bell Farm

Pickerall Company

Pickerall Wildcat Contractor


..... Ft. from N. Line

330 Ft. from S. Line

330 Ft. from E. Line

..... Ft. from W. Line

SE SE NW

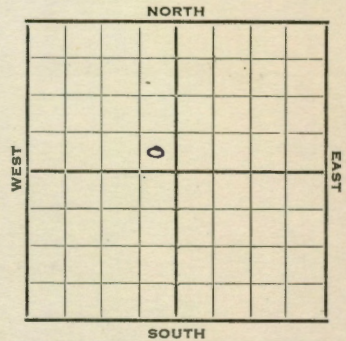

1952 **Elev. 1638'** REPORT

6/18 Spud 6-13-52
8" @ 213'
Drlg. 2470'

6/25 Spud 6-13-52
D&A TD 3733
8" @ 213 **Top 2750 Br lime 2897**
Lans. 2932' Cong 3298 Mis s 3318
DST 3293-3309 opa 1 hr. Rec. 40' gcm
DST 3311-47 opa 1 hr. Rec. 300' gcm
390' vsgcsw **Kh 3352 Viola 3593**
Simp 3636 Arb. 3703 TD 3733
D&A **ABANDONED**

County Rice State Kansas
 Sec. 15 (Blk. Twp.) 21 (Sur. Rge.) 8W Map No.

Operator Pickrell Drlg.
 Well No. 1 Farm Bell

Elev. 1638 Location SE SE NW
 330 Ft. From S Line NW
 330 Ft. From E Line Quarter

Ist. Report
 Completion JUN 25 1952

Remarks Wildcat
Pickrell - Contr.
 Spudding Date 6-13-52

Drlg. Data D & A TD 3733

8" @ 213 Top. 2750 Br. lime 2897
 Lans. 2932 Cong. 3298 Miss. 3318
 DST 3293-3309 open 1 hr. Rec. 40' gcm
 DST 3311-47 open 1 hr. Rec. 300' gcm
 390' vsgcsw Kh. 3352 Viola 3593
 Simp. 3636 Arb. 3703 TD 3733
D & A

J. G. McGEHEE

County Rice State Kansas
 Sec. 15 (Blk. Twp.) 21 (Sur. Rge.) 8W Map No.

Operator Pickrell
 Well No. 1 Farm Bell

Elev. Location SE SE NW
 330 Ft. From S Line NW
 330 Ft. From E Line Quarter


Ist. Report JUN 18 1952

Completion

Remarks Skelly \$ 25000.
Carter NE/4 for \$ 3200.

Pickrell - Contr.
 Spudding Date 6-13-52

Drlg. Data Wildcat
8" @ 213 Drlg. 2470

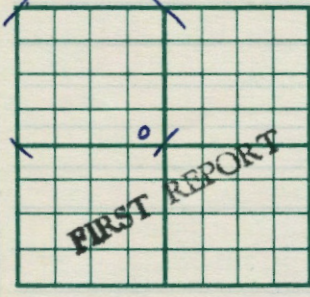

330 Ft. From S Line NW
 330 Ft. From E Line Quarter
 Ist. Report JUN 18 1952
 Completion
 Remarks Skelly \$ 25000.
Carter NE/4 for \$ 3200.
Pickrell - Contr.
 Spudding Date 6-13-52

J. G. McGEHEE