


Section 8 Township 21 Range 13NWell No. #1 FischerCompany Petroleum Inc. & Omega

NORTH

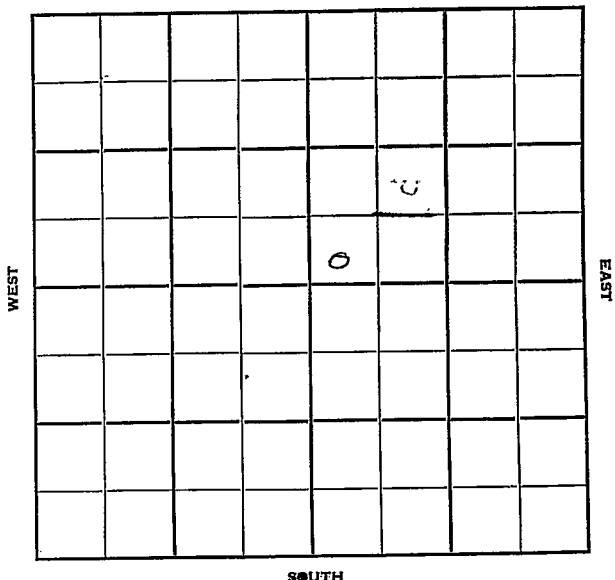

Stafford

KANSAS

8

21

13 W

Sec. _____ Twp. _____ R. _____

1 Fischer

Well No. _____ Farm

Petroleum Inc & Omega

Company

Garvey

Contractor

Hazel


_____ Ft. from N. Line

330 _____ Ft. from S. Line

_____ Ft. from E. Line

330 _____ Ft. from W. Line

SW SW NE

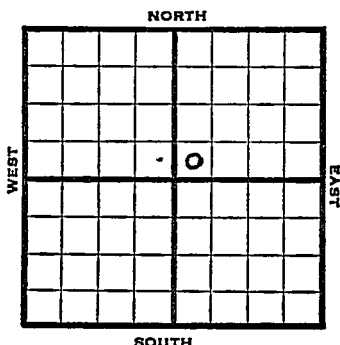

1952

Elev. 1904'

REPORT

1/16

Spud 1-13-52

8" @ 226 WOG

2/6

TD 3650 5" @ 3649

GO to 3645 97/3570-96

2/13

S/1 BOPH 150 A S/2 1/4 BOPH 2000 A

S/1 BOPH plus 3% wtr. PB 3589' To A

2/20

5000 A 5 1/2 BO & 8 1/2 boph PB 3480

32/ 3470-78 500 A S/ 8 boph for

11 hrs. POP

3/5

NR

3/11

"

3/19

"

3/26

Spud 1-13-52

Oil well TD 3650' 8" @ 226

Heeb 3182' Br. lime 3304' Lans 3317

DST 3319-56 open 1 hr, rec 80' mud

DST 3379-99, open 45 min. rec 15' mud

DST 3428-44, open 1 hr, rec 2' hvy oil
28' mud.

DST 3467-78 open 1 hr, rec 75' HOCM

300' oil & muddy oil.

Arb. 3570'

DST 3568-76 open 1 hr. rec 375' clean
oil

DST 3576-86' open 1 hr, rec 750' free
oil

OVER

1952

3/26

(Information continued)

DST 3586-96, open 1 hr, rec 150'
clean oil, 75' HOCM

DST 3596-3606 open 1 hr, rec 7' mud

TD 3650' 5" @ 3649' CO to 3645'

97/3570-96 S/1 BOPH 150 A

S/2 $\frac{1}{4}$ BOPH 2000 A S/1 BOPH

3% water PB 3589' 5000 A

S/1 $\frac{1}{2}$ BO 8 $\frac{1}{2}$ BWPH PB 3480'

32/3470-78 500 A S/8 BOPH

Comp. 471 BOPD


COMPLETED

County Stafford State Kansas
 Sec. 8 (Blk.) 21 (Sur.) 13W Map No.

Operator Petroleum Inc. & Omega

Well No. 1 Farm Fischer

Elev. Location SW SW NE

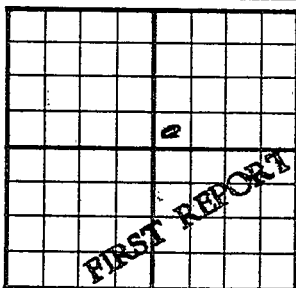

330 Ft. From S Line NE

330 Ft. From W Line Quarter

1st. Report JAN 16 1952

Completion

Remarks

Garvey - Contr.

Spudding Date 1-13-52

Drlg. Data

Hazel

8" @ 226 W.O.C.


J. E. TYRA

JAN 18 1952

Scout Cards *mm*
Land Small Map
Land Wall Map *BP*
Tracings
France Map
Pierce Map
Misc.

Drig. Data

County Stafford State Kansas
 Sec. 8 (Blk.) 21 (Sur.) 13W Map No. _____
 Operator Petroleum Inc. & Omega
 Well No. 1 Farm Fischer
 Elev. 1904 Location SW SW NE

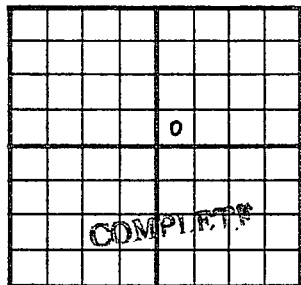

330 Ft. From S Line NE
330 Ft. From W Line Quarter

1st. Report

Completion MAR 26 1952

Remarks Hazel Pool

Garvey - Contr.

Spudding Date 1-13-52

Drilg. Data Oil well TD 3650

8" @ 226 Heeb. 3182 Br. lime 3304

Lans. 3317 DST 3319-56 open 1 hr.

Rec. 80' mud DST 3379-99 open 45 min.

Rec. 15' mud DST 3428-44 open 1 hr.

Rec. 2' hvy oil 28' mud DST 3467-78

open 1 hr. Rec. 75' hocom 300' oil &

muddy oil Arb. 3570 DST 3568-76

open 1 hr. Rec. 375' clean oil

DST 3576-86 open 1 hr. Rec. 750' free

oil DST 3586-96 open 1 hr. Rec.

150' clean oil 75' hocom DST 3596-3606

open 1 hr. Rec. 7' mud TD 3650

5" @ 3649 CO to 3645 97/ 3570-96

J. G. McGEHEE

Scout Cards	<i>mm</i>
Land Small Map	
Land Wall Map	

APR 2 1978

500 A	S / 8 boph	Comp. 471 boph
S / 2 bo	8 1/2 boph	PB 3480 32 / 3470-78
S / 1 boph	3% water	PB 3589 5000 A
S / 1 boph	150 A	S / 2 1/2 boph 2000 A

Orig. Data