

Stafford


KANSAS

SECTION 8 TOWNSHIP 21 RANGE 13W

WELL NO. #2 Fischer "A"

COMPANY Petroleum Inc.

NORTH

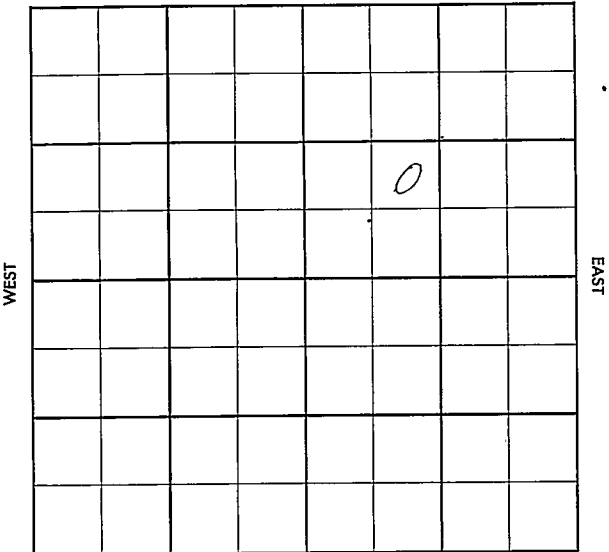

SOUTH

County Stafford Elev. 13W
Sec. 8 Twp. 21 Rge. 13W
Company Petroleum Inc.
Farm Name Fischer "A" No. 2

TOPS	DEPTH	LOG	DATUM	Loc. in Sec.
Anh.	782			NE SW NE
Tr.				
H.				
Tr.				
Dg.				
Bl.				
L.				Geol.
K.C.				Contr.
B.K.C.				Garvey Tools
Ce.				Pool
C.				Dell E.
M.				
M.				
K.				
Mz.				
Ma.				
V.				
S.				
S.				
A.				
R.				
Pe.				
G.				
T.D.				

Date Comm. 12-19-56
8" @ 210 w/175, Drlg. 3199

13

Co.

Lse.

No.

Sec.

T.

R.

County Starford Elev. 1901 RB
 Sec. 8 Twp. 21 Rge. 13W
 Company Petroleum Inc.
 Farm Name Fischer "A" No. 2

TOPS	DEPTH	LOG	DATUM	Loc. in Sec.
Anb.	1785			NE SW NE
TP.				
H.	3179			
Tr.	3200			
Dg.	3216			
BL.	3302			
L.	3314			Geol.
K.C.				Contr.
B.K.C.				
Ce.				Garvey Tools
C. <u>cherty</u>	<u>3562</u>			
M.				Pool
M.				Dell E.
K.				
Mz.				
Me.				
V.				
S.				
S.				
A.	3570			
R.				
PE.				
G.				ABANDONED
TD.	3617			

Date Comm. 12-19-56

8" @ 210 w/175, Drlg. 3199 JAN 2 '57

DST 3316-98 1hr rec 25' Md
 FPO BHP 320/30 DST 3430-49
 1hr rec 15' Md FPO BHP
 60/20" DST 3450-78 op 1hr
 rec 50' Md (550) BHP 110/30"
 DST 3481-3565 1hr rec 62' oil
 spkd M BHP 50/30 DST 3570-77
 1hr rec 60' HOCM BHP 0/30" DST

3577-87 ~~op~~ 15" rec 90' HOCM
+ 240' Md no BHP DST 3574
-87 1hr 480' GIR rec 115'
VHMC0 BHP 210/30" DST

3587-3602 1hr rec 35'

HOCM + 30' OCM + 30' MW

BHP 410 DST 3602-17 ~~op~~

40" rec 15' Md BHP 830/28

D&A