

Section 8 Township 21 Range 13WWell No. 3 Reed "B"Company Cities Service Oil

NORTH

		0					

WEST

EAST

SOUTH

Stafford

KANSAS ✓

Sec. 8 Twp. 21 R. 13W

Well No. #3 Reed "B" Farm

Cities Service Oil Company

Contractor


330 Ft. from N. Line

Ft. from S. Line

990 Ft. from E. Line

Ft. from W. Line

NW NE NW

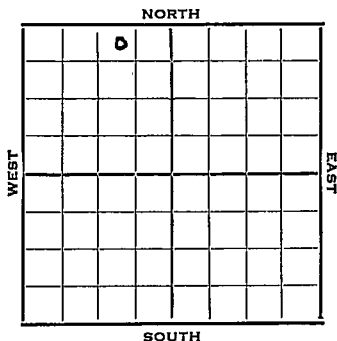

1952 Elev. 1909' REPORT

12/10 Location

12/11 "

12/18 Drlg.

12/25 Drlg.

1/1 Heeb 3189 Br1 3308 Lasn 3320 DST 3400-3415 1 Hr. 36' O&GCM DST 3437-52 1 Hr. 300' MO 1000# DST 3476-90 1 Hr. 35' SOCM BKC 3544 Cong 3562 Simp 3573 Arb 3581 RTD 3584 7" @ 3583
1/8 CO 3584 P/87 BO 8 Hrs. P/10 BOPH 3 Hrs. PB 3560 49/3457-70 F 15 BO 1 Hr. Died P/207 BO 15 Hrs.

1/23 Spud 12-10-52 Oil well TD 3584' 10" @ 360 Heeb 3189' Br. lime 3308 Lans. 3320' DST 3400-15 open 1 hr. rec 36' G & OCM O# DST 3437-52 open 1 hr. rec 300' MCO 380' GCO 1000# DST 3476-90 open 1 hr. rec 35' SOCM O# B KC 3544' Cong. 3562' Simp. 3573' Arb. 3581' TD 3584' 7" @ 3583 CO to 3584' P/87 BO 8 hr. P/10 BOPH PB 3560 49/3457-70 F/15 BO 1 hr. P/207 BO 15 hr. P/67 BO 1 BW 4 hrs. Comp. 1483 BOPD 4% wtr.

COMPLETED

County Stafford State Kansas
 Sec. 8 (Blk.) 21 (Sur.) 13W Map No.
 Operator Cities Service Oil
 Well No. 3 Farm Reed "B"
 Elev. _____ Location NW NE NW

		0					

FIRST REPORT

330 Ft. From N Line NW
990 Ft. From E Line Quarter

Ist. Report DEC 10 1952

Completion _____

Remarks _____

Spudding Date _____

Drlg. Data _____

Location _____

J. G. McGEHEE

County Stafford State Kansas
 Sec. 8 (Blk.) 21 (Sur.) 13W Map No. _____
 Operator Cities Service Oil
 Well No. 3 Farm Reed "B"
 Elev. 1909 Location NW NE NW

		0			

330 Ft. From N Line NW990 Ft. From E Line Quarter

1st. Report _____

Completion JAN 23 1953

Remarks _____

Spudding Date 12-10-52Drig. Data Oil well TD 358410" @ 360 Heeb. 3189 Br. lime 3308Lans. 3320 DST 3400-15 open 1 hr.Rec. 36' g & ocm 0# DST 3437-52open 1 hr. Rec. 300' mco 380' gco1000# DST 3476-90 open 1 hr. Rec.35' socm 0# B KC 3544 Cong. 3562Simp. 3573 Arb. 3581 TD 3584 7" @ 3583CO to 3584 P/ 87 bo 8 hr. P/ 10 bophPB 3560 49/ 3457-70 F/ 15 bo 1 hr.P/ 207 bo 15 hr. P/ 67 bo 1 bw 4 hr.Comp. 1483 bopd. 4% wtr.

J. G. McGEHEE