

Section 8 Township 21 Range 14 WWell No. # 1 WeberCompany Vickers Pet.

NORTH

0							

WEST

EAST

SOUTH

Stafford KANSAS

Sec. 8 Twp. 21 R. 14 W

Well No. # 1 Weber Farm

Vickers Pet. Company

Contractor

Frey Pool

330 Ft. from N. Line


_____ Ft. from S. Line

_____ Ft. from E. Line

330 Ft. from W. Line

NW NW SW

Sunray & Sun - DHM

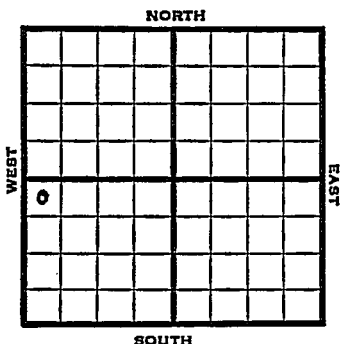

1951

Elev. 1937' REPORT

12/12

Spud 12-8-51
Anhy 872'
8" @ 877' WOC

1952
1/2

Spud 12-8-51
D & A TD 3700' Anhy 872'
8" @ 877' Heeb 3241' Br. lime 3345'
DST 3472-87 open 15 min. rec 4' mud
Viola 3598' Simp. 3631' Arb. 3687'
DST 3690-3700 open 22 min. rec 980' SW
TD 3700' D & A

ABANDONED

County Stafford State Kansas
 Sec. 8 (Blk.) 21 (Sur.) 14W Map No. _____
 Operator Vickers Pet.
 Well No. 1 Farm Weber
 Elev. _____ Location NW NW SW

FIRST REPORT

330 Ft. From N Line SW

330 Ft. From W Line Quarter

1st. Report DEC 1 2 1951

Completion _____


Remarks Sunray & Sun - DEIM

Spudding Date 12-8-51

Drlg. Data Frey Pool

Anhy 872 8" @ 877 WOC

J. E. TYRA

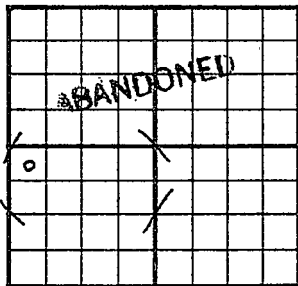County Stafford State KansasSec. 8 (Blk.
Twp.) 21 (Sur.
Rge.) 14W Map No.Operator Vickers Pet.Well No. 1 Farm WeberElev. 1937 Location NW NW SW330 Ft. From N Line SW330 Ft. From W Line Quarter1st. ReportCompletion JAN 2 1952Remarks Frey PoolSpudding Date 12-8-51Drlg. Data D & A TD 3700Anhy 872 8" @ 877 Heeb. 3241Br. lime 3345 DST 3472-87 open 15 min.Rec. 4' mud Viola 3598 Simp. 3631Arb. 3687 DST 3690-3700 open 22 min.Rec. 980' sw TD 3700D & A

J. E. TYRA