


Section 8 Township 21 Range 11W

Well No. 1 Barrett

Company Jayhawk Drlg.

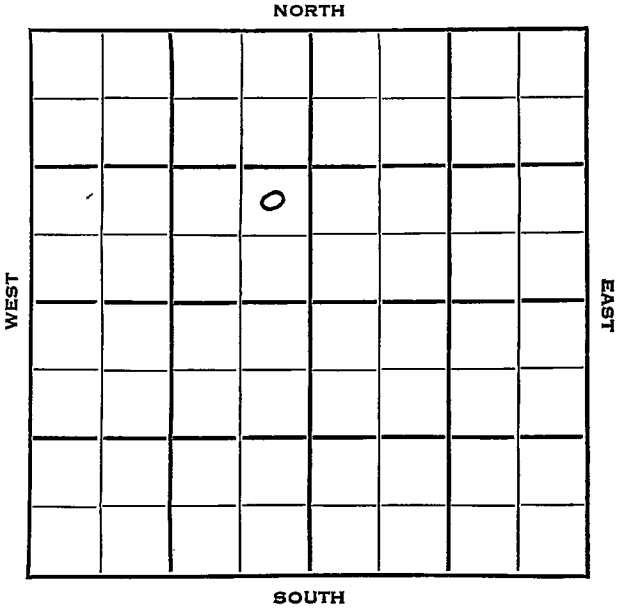

Stafford


KANAS

SEC.	TWP.	R.
8	21	11W ✓

WELL NO. #1 Barrett FARM
 COMPANY

CONTRACTOR Jayhawk Drlg.
 Jayhawk Drlg.

Wildcat.
 _____ Ft. from N. Line
 990 _____ Ft. from S. Line
 330 _____ Ft. from E. Line
 _____ Ft. from W. Line

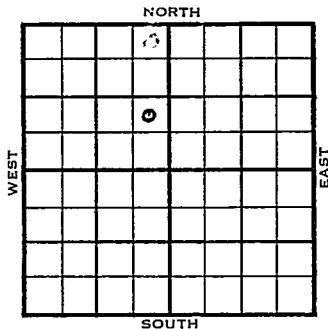

NE SE NW
 Sun F/O

1954	ELEVATION	REPORT
	1933'	

1/27 Spud 1-20-54
 8" @ 867'
 Anhy 863'
 Drlg 2340'

2/3 Spud 1-20-54
 D&A
 TD 3680'
 8" @ 867'
 Anhy 863', Heeb 3226', Tor 3239',
 Doug 3256', Br lime 3329', Lans
 3339', Viola 3578', Simp 3610',
 Arb. 3659'
 DST 3664-80', opn 22 mins., rec.
 2150' sw,
 TD 3680'
 D&A

ABANDONED

County Stafford State Kansas

Sec. 8 (Blk. Twp.) 21 (Sur. Rge.) 14W Map No.

Operator Jayhawk Drlg.

Well No. 1 Farm Barrett

Elev. _____ Location NE SE NW

		0			
FIRST REPORT					

990 Ft. From S Line NW

330 Ft. From E Line Quarter

Ist. Report JAN 27 1954

Completion _____

Remarks Sun farmout

Jayhawk - Contr.

Spudding Date 1-20-54

Drlg. Data Wildcat

8" @ 867 Anhy 863 drlg. 2340

J. G. McGEHEE

