


Section 8 Township 21 Range 15W

Well No. #1 Sweeny "A"

Company G-M-R Oil

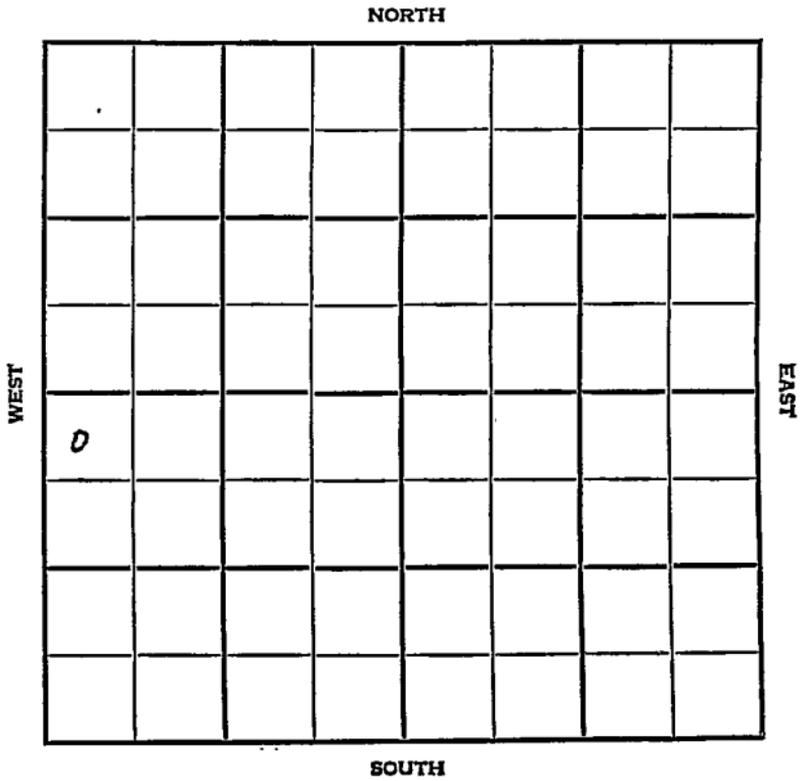

Pawnee

SEC.	TWP.	R.
8	21	15W

WELL NO. #1 Sweeny "A" FARM

COMPANY G-M-R Oil

CONTRACTOR


SW Sweeney Pool

330 \_\_\_\_\_ Ft. from N. Line

\_\_\_\_\_ Ft. from S. Line

\_\_\_\_\_ Ft. from E. Line

330 \_\_\_\_\_ Ft. from W. Line

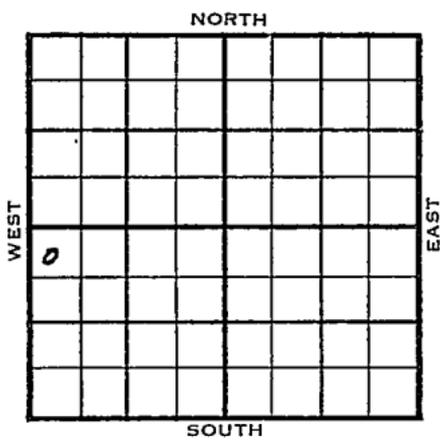

NW NW SW

1954	ELEVATION	REPORT
	1958'	

10/13 Spud 10-11-54  
 Anhy 932'  
 Drlg. 942'

11/10 Spud 10-11-54  
 SI Gas Well.  
 TD 3841'  
 Anhy 932'  
 8-5/8" @ 952'  
 Heeb 3324' Br. Lime 3421', Lans 3432'  
 Cong 3692', Viola 3720', Simp 3756'  
 Arb 3791'  
 DST 3835'-41' opn 1 1/2 hr, gas in 4 min  
 spray oil in 90 min,  
 TD 3841'  
 5" @ 3841'  
 DD 3843' 50 go 5 gwph SP 3836'  
 40/ 3823-33  
 Comp. shut in gas well  
 5,000,000 cfcpd.

COMPLETED



