

DX 78-1

O.W.W.O.


Pawnee

KANSAS

Section 8 Township 21 Range 15 W

Well No. # 1 Sweeny "B"

Company G-M-R Oil

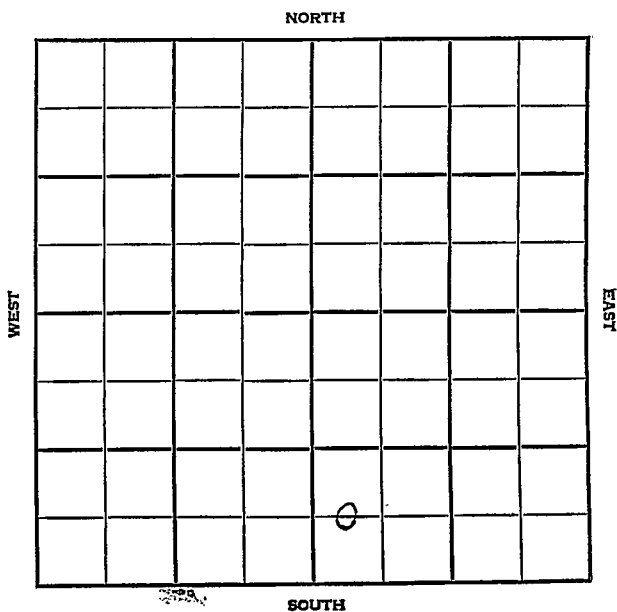

O.W.W.O.

Pawnee

KANSAS


SEC.	TWP.	R.
8	21	15 W

WELL NO. # 1 Sweeny "B" FARM

COMPANY G-M-R Oil

CONTRACTOR Co. tools

Sweeny Pool  
 \_\_\_\_\_ Ft. from N. Line  
 660 \_\_\_\_\_ Ft. from S. Line  
 \_\_\_\_\_ Ft. from E. Line  
 330 \_\_\_\_\_ Ft. from W. Line

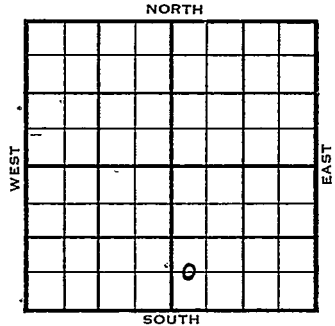

C W 1/2 SW SE.

	ELEVATION	REPORT
1954	1954'	

12/1 Spud 11-23-54  
 8" @ 946 Anhy 931 Heeb 3336  
 Br. lime 3436 Lans 3448  
 Drlg. 3567'

1955  
 2/9 Spud 11-23-54 - Oil Well  
 TD 3860'  
 8" @ 946'  
 Anhy 931', Heeb. 3336', Br lime 3436',  
 Lans. 3448', Cong. 3710'  
 DST 3775-83', opn 1 hr., rec. 10' mud,  
 140#  
 Arb. 3802'  
 DST 3830-40', opn 1 hr., gas in 1 1/2",  
 2,060,000 cfg in 5", 2,190,000 cfg in  
 10", spray oil in 12", rec. 105' oil,  
 15' wtr., ~~161000~~ 1060#  
 TD-3860'  
 5" @ 3860'  
 CO to 3854', 24/3835-41, 3 1/2 boph  
 S/4 boph 14% wtr., 100,000 cfg 250A  
 F/20 bo 25 bfph dec. to 15 bfph  
 40% wtr., 1,000,000 cfg  
 F/15 boph 40% wtr., 8 hrs.  
 Comp. 35 bopd 17% wtr.  
 1,500,000 cfg

OVER

COMPLETED

1955  
7/13

## O.W.W.O.

Old info: OTD 3860' 5" @ 3860  
Was Arb. well  
NEW INFO: MICT - CO Sqz old perms  
at 3835-41 w/75 sx. CO  
32/3822-30 1000 A  
Flo 6,000,000 CFG + 7 BFPH. (10% oil,  
90% wtr) 5 hrs. Sqz w/75 sax.  
CO 3828'; 10/3820-25, gd sho gas.  
250 MA + 1000 reg A. Test 6,000,000  
CFG + 7 BFPH. Sqz w/50 gal plastic  
CO \*18/3808-14 Flo 500,000 CFG.  
1000 A. 4,500,000 CFG\* 3 bbl acid  
wph, no oil  
G/ 4,500,000 CFG, no RP  
Arb. perf 3808-14  
KC 3448', C. 3710' Arb. 3802'

**FIRST REPORT**  
**COMPLETED**



Scout Cards

*mm*

DEC 3

1951

Long Snail Map

Land Wall Map

Training

France Map

Pierce Map

Misc.

*3*

Prig. Data

County Pawnee State Kansas

Sec. 8 (Blk.) 21 (Sur. Rge.) 15W Map No.

Operator G-M-R Oil

Well No. 1 Farm Sweeney "B"

Elev. 1954 Location C W<sup>1</sup>/<sub>2</sub> SW SE


660 Ft. From S Line SE

330 Ft. From W Line Quarter

1st. Report

Completion FEB 9 1955

Remarks Sweeney Pool

Co. tools

Spudding Date 11-23-54

Drlg. Data Oil well TD 3860

8" @ 946 Anhy 931 Heeb. 3336

Br. lime 3436 Lans. 3448 Cong. 3710

DST 3775-83 open 1 hr. Rec. 10' mud

140# Arb. 3802 DST 3830-40 open 1 hr.

gas in 1 $\frac{1}{2}$  min. 2,060,000 cfg in 5 min.

2,190,000 cfg in 10 min. spray oil in

12 min. Rec. 105' oil 15' wtr.

1060# TD 3860 5" @ 3860 CO to 3854

24/ 3835-41 3 $\frac{1}{2}$  boph S/ 4 boph 14% wtr.

100,000 cfg 250 A F/ 20 go 25 bfph

dec. to 15 bfph 40% wtr. 1,000,000 cfg

F/ 15 boph 40% wtr. 8 hr.

Comp. 35 bopd 17% wtr. 1,500,000 cfg

FABEN GILSTRAP

FEB 15 1968  
ad  
3  
Miss. Drig: Data

O.W.W.O. *owwo*

FORM 513 REV. SUNRAY

County Pawnee Elevation 1954 DF  
1957 RB  
 Sec. 8 Twp. 21S Rge. 15W  
 Company Graham-Messman & Rinehart  
 Farm Name Sweeny "B" No. 1

TOPS	DEPTH	LOG	DATUM
Anh.			
Tp.			
H.			
Tr.			
Dg.			
Bl.			
L. <u>KC</u>	<u>3148</u>		
K.C.			
B.K.C.			
Ce.			
C. <u>3710</u>			
M.			
M.			
K.			
Mz.			
Mq.			
V.			
S.			
S.			
A. <u>3802</u>			
R.			
PE.			
G.			
T.D.			

Loc. in Sec. (OWWO)  
W/2 SW SE  
 Geol. \_\_\_\_\_  
 Contr. \_\_\_\_\_  
 Pool \_\_\_\_\_  
Sweeny  
 JUL 13 1955  
 FIRST REPORT  
 COMPLETE

Date Comm. Old info - OTD 3860; 5 1/2" 3860; was Arb. well

New info - MICT - CO - sqz old perfs at 3835-41  
41 w/75 sx; CO 32/3822-30; 1000 A;  
flo 6,000,000 cfg / 7 bfph (10% oil 90% wt)  
5 hrs.; sqz w/75 sx; CO 3828; 10/3820-25;  
gd sho gas; 250 MA / 1000 reg A; test  
6,000,000 cfg / 7 bwph; sqz w/50 gal. plastic  
CO; 18/3808-14; flo 500,000 cfg; 1000 A;  
4,500,000 cfg / 3 bbl. acid wph no oil;

OVER

ga. 4,500,000 ofg - no RP

Arb. perf. 3808-74

¢

Scout Cards	<i>MM</i>
Land Small Map	_____
Land Wall Map	_____
Tracings	_____
Fence Map	_____
Pierce Map	_____
Misc.	_____

APR 18 1955