

Rice


KANSAS

Form 51-5M 5-37 Petrol

Section 8 Township 21 Range 7-W


Well No. 3 Gossman

Company Gulf

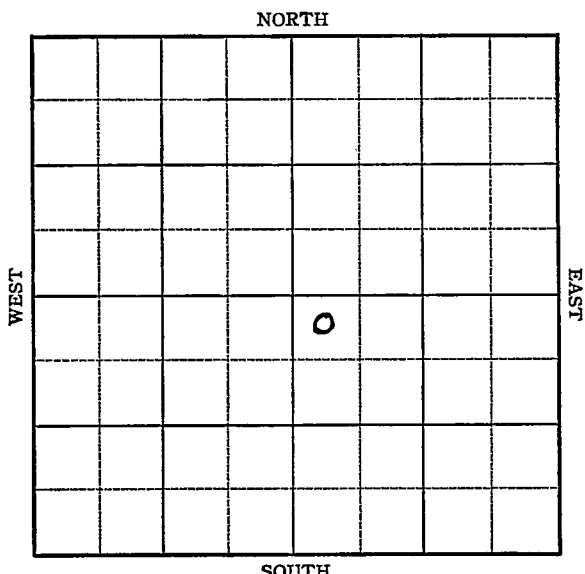

Sec. 8 Twp. 21 R. 7-WWell No. #3 Gossman Farm
Gulf Company330 Ft. from N. Line Ft. from S. Line Ft. from E. Line330 Ft. from W. Line

Elev. 1620

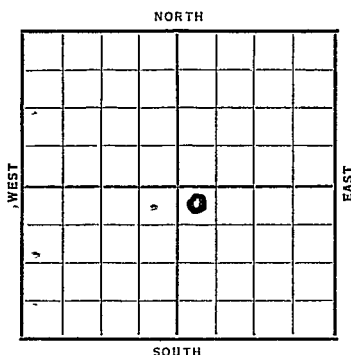

Date

REPORT

1937

12/15

B. R. R.

12/24

10" @ 178'. Drlg. 1030'.

12/31

Drlg. 2725'.

1938

1/7

T.D. & 7" @ 3324'. RUST.

1/14

Cong. 3324'. S.O. 3345-49'.

Miss. 3350'. Drlg. 3385'.

1/20

T.D. 3390' 600' fluid P.B.

3359' Shot 40 qts. C.O.

1/28

T.D. 3359' Shot 50 qts. 3356-40'

Cleaning out.

2/4

" " " " " "

2/11

Swab 33 oil in 6 hrs.

Rng. liner.

2/18

Cong. 3329' (Corrected)

Cleaning out

OVER

1938

2/23 7" @ 3324'.
Cong. 3329' (Corrected)
Miss. 3350'.
T.D. 3390'.
P.B. 3359'.
Shot 40 qts. 3332-59'.
50 qts. 3340-50'.
Potential 101 bbls.

COMPLETED

Rice

KANSAS

Map No. 49 Sec. 8 Twp. 21 R. 7WWell No. 3 GossmanGulf

Company

Contractor

FIRST REPORT

NW SE

330 Ft. from N. Line Ft. from S. Line Ft. from E. Line330 Ft. from W. Line

SECTION PLAT

		0	

Location Rig up

Drilling and Remarks:

BRR

RECORD

Cased in., ft.Sand Gas Oil Total Depth

PRODUCTION

1st 24 hrs. Nat. 1st 24 hrs. after shot Gas Cu. Ft.Dry Hole Abandoned

Date

DEC 15 1937 19H. D. Hatfield Scout

RAY

Returned _____

Cards _____

Tracing _____

Photo Map _____

See 1st Map _____

Map _____

Scarlett's P. Book _____

Moody's Book _____

Rice

KANSAS

Map No. 49 Sec. 8 Twp. 21 R. 7WWell No. 3 GossmanGulf

Company

Contractor

COMPLETED

NW SE

330 Ft. from N. Line

_____ Ft. from S. Line

_____ Ft. from E. Line

330 Ft. from W. Line

SECTION PLAT

		0	

Location _____

Rig up _____

Drilling and Remarks:

P.B. 3359

Shot 40 gts 3332-59
50 gts 3340-56

Pot 101

RECORD

Cased 7 in. 3324 ft.Sand Cong 3329 (correct)Gas MISS 3350

Oil _____

Total Depth 3390

PRODUCTION

1st 24 hrs. Nat. !

1st 24 hrs. after shot _____

Gas _____ Cu. Ft.

Dry Hole _____

Abandoned _____

Date

FEB 23 1938

19

H. D. Hatfield Scout

John.

Returned _____

Cards _____

Tracing _____

France Map _____

Seaborough Map _____

Moody Map _____

Seaborough Flat Book _____

Moody Flat Book _____