

KANSAS


Form 51-5M-7-39-Palace

Rice

Section 8 Township 21 Range 7-W

Well No. #6 Gossman

Company Grace Oil

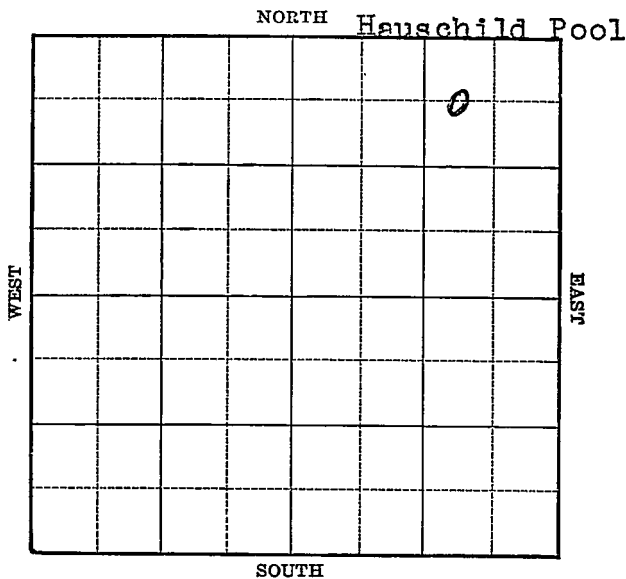

Rice

KANSAS

Map No. 49 Sec. 8 Twp. 21 R. 7WWell No. 6 Gossman

Grace Oil

Company

Contractor

FIRST REPORT

C $W\frac{1}{2}$ NE NE660 Ft. from N. Line Ft. from S. Line990 Ft. from E. Line Ft. from W. Line

HAUSCHILD POOL

SECTION PLAT

			0

Location Rig up Drilling and Remarks:

Derrick

RECORD

Cased in., ft.Sand Gas Oil Total Depth

PRODUCTION

1st 24 hrs. Nat. 1st 24 hrs. after shot Gas Cu. Ft.Dry Hole Abandoned

Date

OCT 11 1939

19

S. J. LEWIS

Scout

Map No. 49 Sec. 8 Twp. 21 R. 7WWell No. 6 GossmanGrace Oil

Company

Contractor

COMPLETED

C $W\frac{1}{2}$ NE NE660 Ft. from N. Line

Ft. from S. Line

990 Ft. from E. Line

Ft. from W. Line

HAUSCHILD POOL

SECTION PLAT

			0

Location

Rig up

Drilling and Remarks:

*Core 3349**700 3349**Flow 1875 P.S.*

RECORD

Cased _____ in., _____ ft.

Sand _____

Gas _____

Oil _____

Total Depth 3369

PRODUCTION

1st 24 hrs. Nat. _____

1st 24 hrs. after shot _____

Gas _____ Cu. Ft.

Dry Hole _____

Abandoned _____

Date

NOV 22 1939 19

S. J. LEWIS Scout