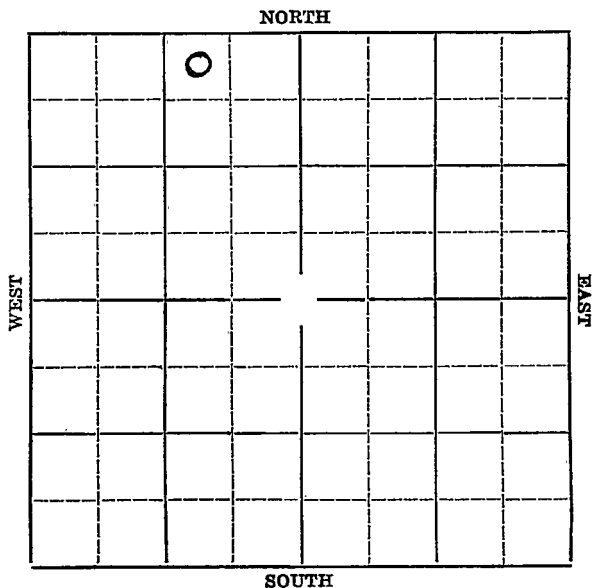
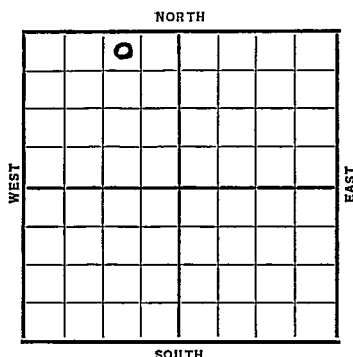


KANSAS

Rice

Section 8 Township 21 Range 7WWell Number 1 Gossman "B"Company Atlantic Ref.

O. W. D. D

Sec. 8 Twp. 21 R. 7 ~~W~~Well No. #1 Gossman "B" FarmAtlantic Ref. Company330 Ft. from N. Line Ft. from S. Line990 Ft. from E. Line Ft. from W. Line~~1937~~

REPORT

O. W. D. D

3/17 Rigging up

3/25 10" @ 108'. Drlg. 1400'.

4/2 Drlg. 3106'.

4/8 7" @ 3326' Conglomerate 3327'
hole full oil.

4/14 Conglomerate 3327'.

T.D. 3339½'.

Potential 4942.

~~COMPLETED~~

1937

O. W. D. D

6/16 O.T.D. 3339½'.

Drilled 3345' T.D. Show water.

P.B. 3340'.

Pump 229 bbls. 6 hrs.

Pot. 768 bbls.

FIRST REPORT

and
COMPLETED

KANSAS

Rice

Map No. 49 Sec. 8 Twp. 21 R. 7WWell No. 1 Gossman "B"Atlantic Ref. Company

Contractor

SECTION PLAT

	0		

230 Ft. from N. Line

_____ Ft. from S. Line

290 Ft. from E. Line

_____ Ft. from W. Line

FIRST REPORT

Location _____

Rig up _____

Drilling and Remarks:

Rigging up

RECORD

Cased _____ in., _____ ft.

Sand _____

Gas _____

Oil _____

Total Depth _____

PRODUCTION

1st 24 hrs. Nat. _____

1st 24 hrs. after shot _____

Gas _____ Cu. Ft.

Dry Hole _____

Abandoned _____

Date

MAR 17 1937

19

S. J. LEWIS

Scout

KANSAS *Rice*Map No. _____ Sec. *8* Twp. *21* R. *7W*Well No. *1 Gossman "B"**Atlantic Ref.* Company

Contractor _____

SECTION PLAT

	<i>0</i>		

330 Ft. from N. Line

_____ Ft. from S. Line

990 Ft. from E. Line

_____ Ft. from W. Line

COMPLETED

RECORD

Location _____

Cased _____ in., _____ ft.

Rig up _____

Sand _____

Drilling and Remarks:

Gas _____

Oil _____

Total Depth *3339 1/2* "

PRODUCTION

1st 24 hrs. Nat. _____

1st 24 hrs. after shot _____

Gas _____ Cu. Ft.

Dry Hole _____

Abandoned _____

Date

APR 14 1937

19

S. J. LEWIS

Scout

Rice KANSAS

Map No. 49 Sec. 8 Twp. 21 R. 7 WWell No. 1 - Gossman "B"Atlantic Ref Company

FIRST REPORT

Contractor

COMPLETED

SECTION PLAT

	0		

330 Ft. from N. Line Ft. from S. Line990 Ft. from E. Line Ft. from W. LineO.W.D.D.Location Rig up

Drilling and Remarks:

O.T.D. 3339 1/2Drilled 3345 T.D.Show waterP.B. 3340Pump 229/6 hrsPat 768

RECORD

Cased in., ft.Sand Gas Oil Total Depth 3345

PRODUCTION

1st 24 hrs. Nat. 1st 24 hrs. after shot Gas Cu. Ft.Dry Hole Abandoned

Date

JUN 16 1937

19

H. D. Hatfield

Scout