
Form 51-5M-12-36 Com'l Rice KANSAS

Section 8 Township 21 Range 7-W

Well Number 2 - Thode

Company Derby Oil

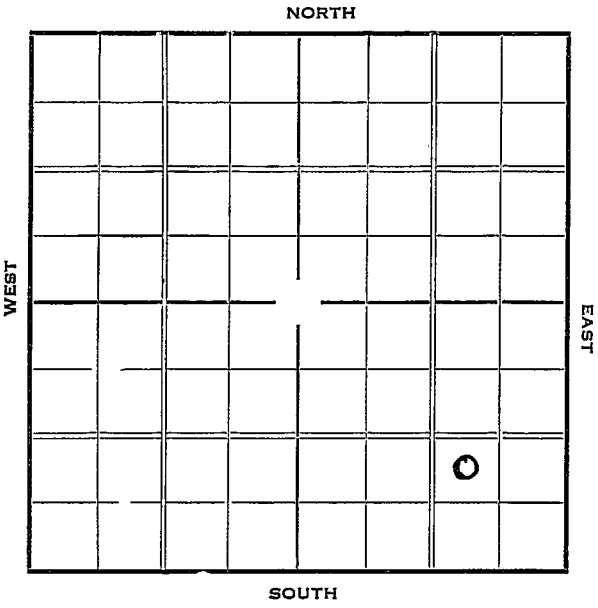


Form 252-A—5M—2-37—Palace KANSAS Rice

Sec. 8 Twp. 21 R. 7-W

Well No. 2 - Thode Farm

Derby Oil Company

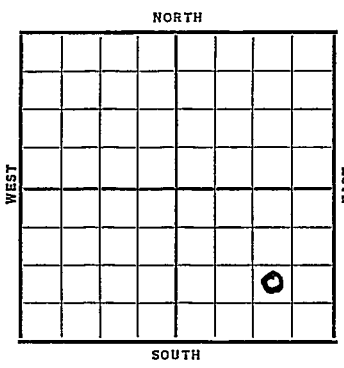

_____ Ft. from N. Line

990 Ft. from S. Line

990 Ft. from E. Line

_____ Ft. from W. Line

Elev. 1621

Date	REPORT
1937	
4/28	Cellar
5/7	Rig
5/14	12" @ 103'. WOC.
5/21	Drlg. 2220'.
5/28	K.C. 2880'. Drlg. 3160'.
6/4	Cong. & 7" @ 3352'.
6/9	7" @ 3352'.
	Cong. 3352'.
	T.D. 3373'.
	Flowed 537 bbls. 6 hrs.
	Pot. 1035 bbls.
	COMPLETED

Form 26—1M Bks.—2-29 Rice KANSAS

Map No. _____ Sec. 8 Twp. 21 R. 7 W

Well No. 2 - Rhode

Derby Oil Company

_____ Contractor

FIRST REPORT


_____ Ft. from N. Line

990 Ft. from S. Line

990 Ft. from E. Line

_____ Ft. from W. Line

SECTION PLAT

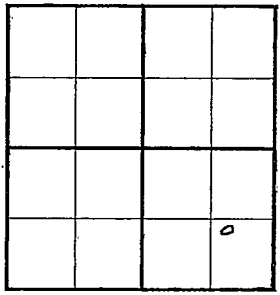

Location _____

Rig up _____

Drilling and Remarks:

Cellar

RECORD

Cased _____ in., _____ ft.

Sand _____

Gas _____

Oil _____

Total Depth _____

PRODUCTION

1st 24 hrs. Nat. _____

1st 24 hrs. after shot _____

Gas _____ Cu. Ft.

Dry Hole _____

Abandoned _____

Date

APR 28 1937 19

H. D. Hatfield Supt

Form 26—1M Bks.—2-29 Rice KANSAS

Map No. 49 Sec. 8 Twp. 21 R. 7W

Well No. 2 - Thode

Derby Company

Contractor

COMPLETED


Ft. from N. Line

990 Ft. from S. Line

990 Ft. from E. Line

Ft. from W. Line

SECTION PLAT

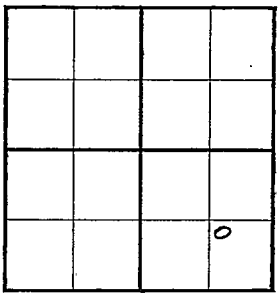

Location

Rig up

Drilling and Remarks:

Plowed 537/6 hrs

Pot - 1035

RECORD

Cased 7 in., 3352 ft.

Sand Cong - 3352

Gas

Oil

Total Depth 3373

PRODUCTION

1st 24 hrs. Nat.

1st 24 hrs. after shot

Gas Cu. Ft.

Dry Hole

Abandoned

Date

JUN 9 1937 19 H. D. Hatfield Scout