
Form 51-5M-12-36 Com'l

Rice KANSAS

Section 8 Township 21 Range 7-W

Well Number 3 - Mills

Company Atlantic

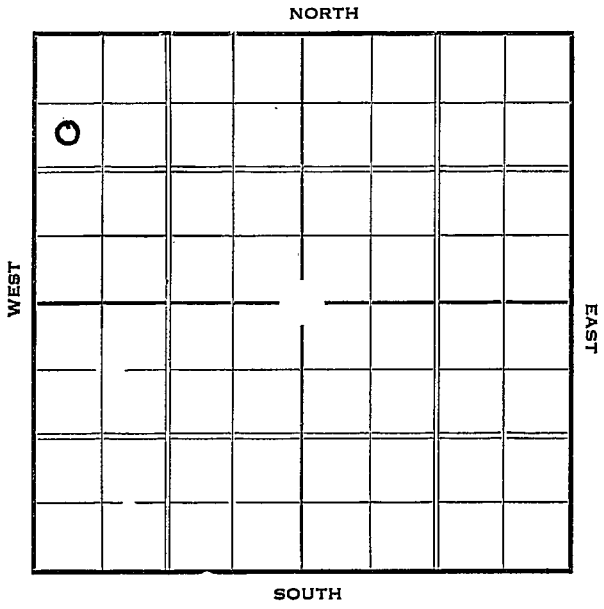

Form 252-A—5M—2-37—Palace KANSAS Rice

Sec. 8 Twp. 21 R. 7-W

Well No. #5 Mills Farm

Atlantic Company


990 Ft. from N. Line

Ft. from S. Line

Ft. from E. Line

330 Ft. from W. Line

Elev. 1624

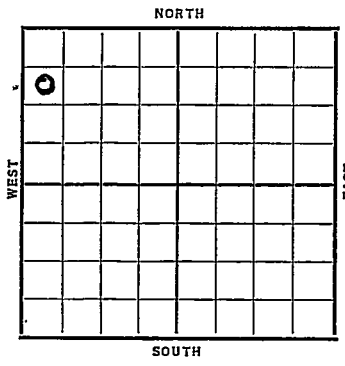

Date	REPORT
1937	
5/5	Location
5/14	R. R.
5/21	12" @ 110'. Drlg. 1118'.
5/28	Drlg. 2788'.
6/4	7" @ 3327'. T.D. 3328'. WOC
6/11	T.D. 3342'. 300 Water 1 hour
	Will P.B.
6/19-	Shot 30 qts. 3000' oil.
	No water.
6/25	SD orders.
7/2	" "
7/9	" "
7/16	" "
7/23	" "
	OVER

1937

7/28 7" @ 3327'.

Cong. 3332'.

T.D. 3342'.

Shot 30 qts. 3330-40'.

15 bbls. per day.

COMPLETED

Form 26—1M Bks.—2-29 Rice KANSAS

Map No. 49 Sec. 8 Twp. 21 R. 7 W

Well No. 3 - Mills

Atlantic Company

Contractor

FIRST REPORT


990 Ft. from N. Line

_____ Ft. from S. Line

_____ Ft. from E. Line

330 Ft. from W. Line

SECTION PLAT

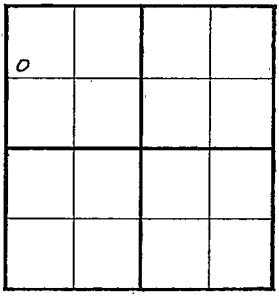

Location ✓

Rig up

Drilling and Remarks:

RECORD

Cased _____ in., _____ ft.

Sand

Gas

Oil

Total Depth

PRODUCTION

1st 24 hrs. Nat.

1st 24 hrs. after shot

Gas _____ Cu. Ft.

Dry Hole

Abandoned

Date

MAY 5 - 1937 19 H. D. Hatfield Scout

Form 26—1M Bks.—2-29 Rice KANSAS

Map No. Sec. 8 Twp. 21 R. 7W

Well No. 3- Mills

Atlantic Company

Contractor

COMPLETED


990 Ft. from N. Line

Ft. from S. Line

Ft. from E. Line

330 Ft. from W. Line

SECTION PLAT

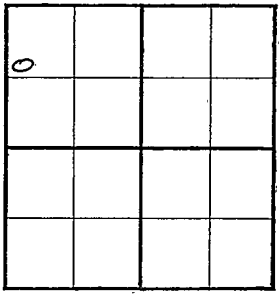

Location

Rig up

Drilling and Remarks:

Shot 30 qts
3330-40.

15 Bbls. per day

RECORD

Cased 7 in., 3327 ft.

Sand Cong 3332

Gas

Oil

Total Depth 3342

PRODUCTION

1st 24 hrs. Nat.

1st 24 hrs. after shot

Gas Cu. Ft.

Dry Hole

Abandoned

Date

JUL 28 19

H. D. Hatfield Scout