


Section 8 Township 21 Range ~~9-W~~  
~~9-W~~

Well No. 1 - Ehlers

Company Elbar Corp.

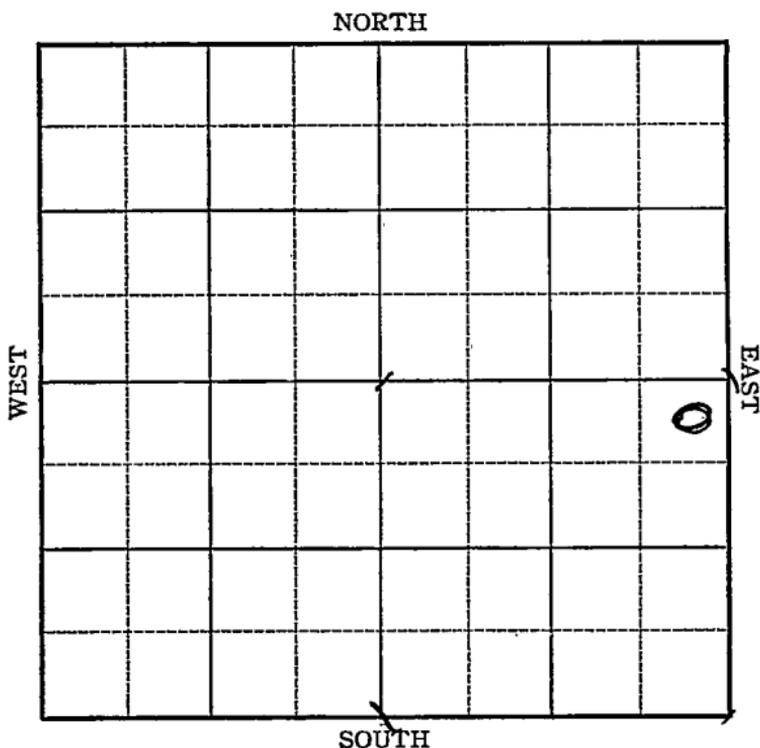

Sec. 8 Twp. 21 R. 9 W

Well No. #1 Ehlers Farm  
Elbar Corp. Company


330 Ft. from N. Line

\_\_\_\_\_ Ft. from S. Line

330 Ft. from E. Line

\_\_\_\_\_ Ft. from W. Line

Elev. 1685

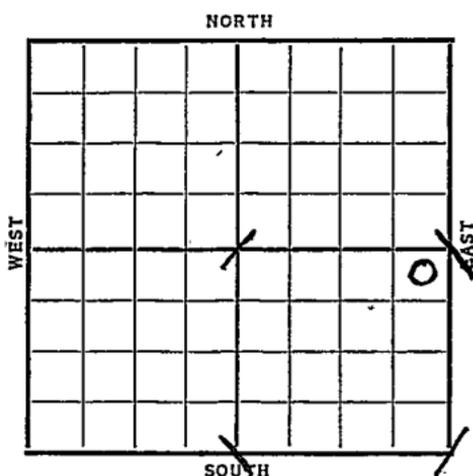

Date	REPORT
1937	
9/1	<del>MAN</del> . Mat.
9/10	R. R.
9/17	"
9/24	"
10/2	"
10/8	R U R
10/15	12" @ 75'. Drlg. 1200'.
10/22	Topeka 2515'. K.C. 2995'.
	Drlg. 3008'. No shows reported.
10/29	Cong. 3316'. Viola 3410'.
	Coring 3430'. No shows.
	OVER

1937

11/3 K.C. 2956-3284'.  
Cong. 3306'.  
Kinderhook 3308'.  
Viola 3397'.  
Simp. 3465'.  
Sil. 3523-34'.  
T.D. 3534'.  
Water.

**ABANDONED**

Rice KANSAS

Map No. \_\_\_\_\_ Sec. 8 Twp. 21 R. 9WWell No. 1- Ehlers  
Ehlers Corp. Company

Contractor \_\_\_\_\_

## FIRST REPORT

## SECTION PLAT


330 Ft. from N. Line

\_\_\_\_\_ Ft. from S. Line

330 Ft. from E. Line

\_\_\_\_\_ Ft. from W. Line

Location \_\_\_\_\_

Rig up \_\_\_\_\_

Drilling and Remarks:

Mah

## RECORD

Cased \_\_\_\_\_ in., \_\_\_\_\_ ft.

Sand \_\_\_\_\_

Gas \_\_\_\_\_

Oil \_\_\_\_\_

Total Depth \_\_\_\_\_

## PRODUCTION

1st 24 hrs. Nat. \_\_\_\_\_

1st 24 hrs. after shot \_\_\_\_\_

Gas \_\_\_\_\_ Cu. Ft.

Dry Hole \_\_\_\_\_

Abandoned \_\_\_\_\_

Date

SEP 1 1937 19

H. D. Hatfield Scout

Rice

Map No. \_\_\_\_\_ Sec. 8 Twp. 21 R9W

Well No. 1 Ehlers

Elbar Corp. Company

Contractor

ABANDONED

NE SE

330 Ft. from N. Line

\_\_\_\_\_ Ft. from S. Line

330 Ft. from E. Line

\_\_\_\_\_ Ft. from W. Line

SECTION PLAT

			0

Location \_\_\_\_\_

Rig up \_\_\_\_\_

Drilling and Remarks:

*K.C. 2956-3284*  
*cong 3306*  
*Kinderhook 3308*  
*Viola 3397*  
*Smp 3465*  
*sil. 3523-3470*  
*water DVA*

RECORD

Cased \_\_\_\_\_ in., \_\_\_\_\_ ft.

Sand \_\_\_\_\_

Gas \_\_\_\_\_

Oil \_\_\_\_\_

Total Depth \_\_\_\_\_

PRODUCTION

1st 24 hrs. Nat. \_\_\_\_\_

1st 24 hrs. after shot \_\_\_\_\_

Gas \_\_\_\_\_ Cu. Ft.

Dry Hole \_\_\_\_\_

Abandoned \_\_\_\_\_

Date

NOV 3 1937

H. D. Hatfield Scout