


KANSAS

Rice County

Section 8 Township 21 Range 9W

Well No. 1 Stout

Company Omar Drlg.

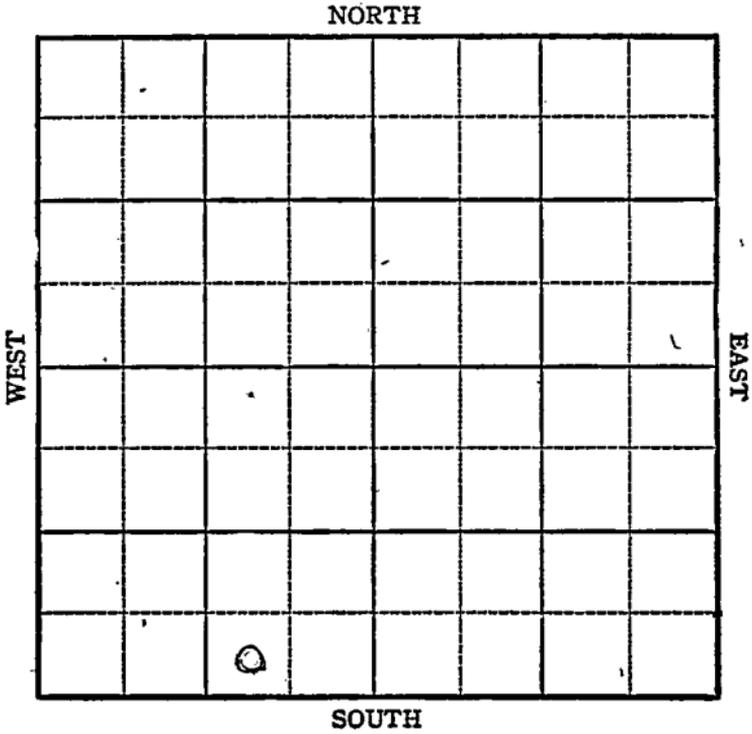

KANSAS

Rice

21

9W

Sec. 8 Twp. _____ R. _____

Well No. #1 Stout Farm _____

Omar Drlg. Company _____


Wildcat

_____ Ft. from N. Line

330' Ft. from S. Line

990' Ft. from E. Line

_____ Ft. from W. Line

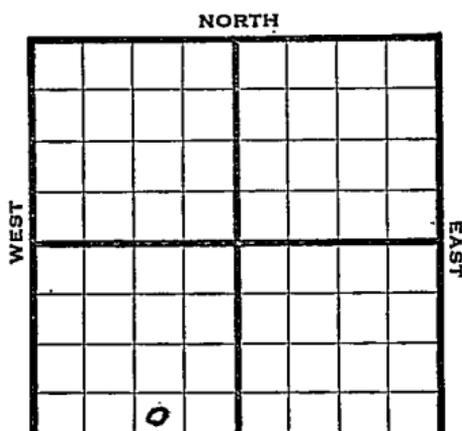

Elev. 1686

1944

REPORT

6/28

Spud

7/2

- Lans 2980
- Viola 3290
- Simp 3325
- Arb 3387
- TD 3425

ABANDONED

Pool Name Wildcat

Map No. KANSAS Sec. 8 Twp. 21 R. 9W

Well No. 1 Stout

Omar Drlg. Company

FIRST REPORT Contractor

SW SE SW

SECTION PLAT

_____ Ft. from N. Line

330 Ft. from S. Line

990 Ft. from E. Line

_____ Ft. from W. Line

Rice County

Location _____

Rig up _____

Drilling and Remarks:

Spud

RECORD

Cased _____ in., _____ ft.

Sand _____

Gas _____

Oil _____

Total Depth _____

PRODUCTION

1st 24 hrs. Nat. _____

1st 24 hrs: after shot _____

Gas _____ Cu. Ft.


Dry Hole _____

Abandoned _____

Date

JUN 28 1944 19

S. J. LEWIS Scout

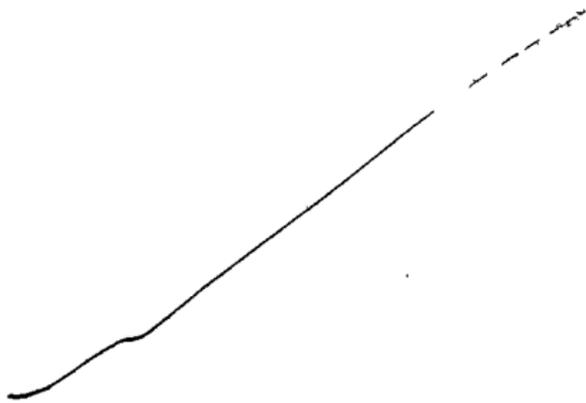

Misc. Small Maps	<i>Om</i>
Cards	<i>Betty</i>
Tracing	<i>W. G.</i>
France Map	<i>W. G.</i>
Scarborough Map	<i>W. G.</i>
Moody Map	<i>W. G.</i>
Geological Dept.	
Moody Plat Book	

KANSAS

Pool Name Wildcat

Map No. 49 Sec. 8 Twp. 21 R. 9W

Well No. 1 Stout

Omar Drlg. Company

ABANDONED Contractor

SW SE SW

SECTION PLAT

	6		

 Ft. from N. Line

330 Ft. from S. Line

990 Ft. from E. Line

 Ft. from W. Line

Rice County

Location

Rig up

Drilling and Remarks:

Lease 2880

Vida 3280

Buy 3325

Per 3387

RECORD

Cased in., ft.

Sand

Gas

Oil

Total Depth 2425

PRODUCTION

1st 24 hrs. Nat.

1st 24 hrs. after shot

Gas Cu. Ft.

Dry Hole


Abandoned

Date

JUL 12 1944 19

S. J. LEWIS

Scout

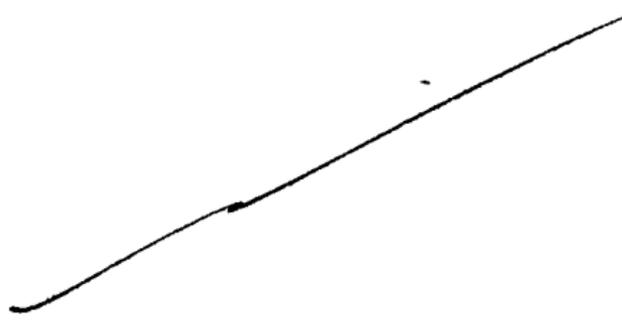

Misc. Small Maps.	<i>Orna</i>
Cards	<i>Orna</i>
Tracing	<i>Orna</i>
France Map	<i>Orna</i>
Scarborough Map	<i>Orna</i>
Moody Map	<i>Orna</i>
Geological Draw	<i>Orna</i>
Moody Plat Book	