


Section 8 Township 21 Range 11 W

Well No. # 1 Kasselman

Company Duke & Wood

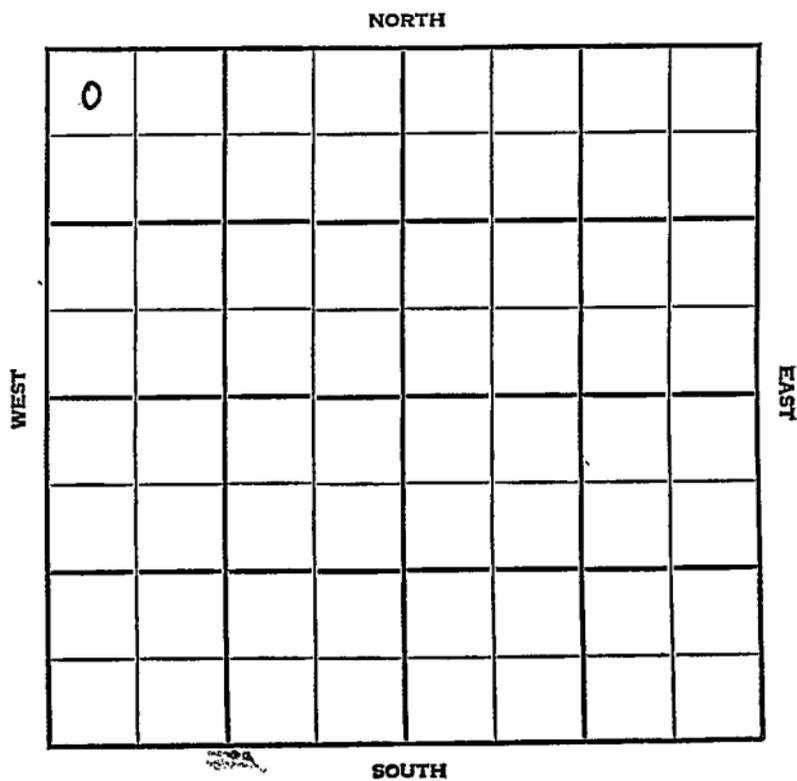

# Stafford

K 4111111111

SEC. 8	TWP. 21	R. 11W
--------	---------	--------

WELL NO. **#1 Kasselman** FARM

COMPANY **Duke & Wood**

CONTRACTOR **Co. Tools.**


**San Dago Pool**

330 Ft. from N. Line

\_\_\_\_\_ Ft. from S. Line

\_\_\_\_\_ Ft. from E. Line

330 Ft. from W. Line

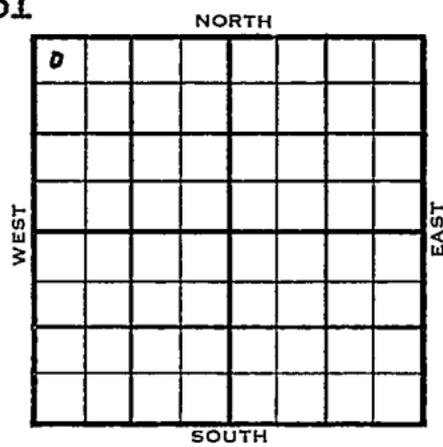

NW NW NW

	ELEVATION	REPORT
1954	1808'	
12/1		Spud 11-30-54
12/29		Spud 11-30-54 - Oil Well TD 3439' 8" @ 244' Anhy 564', Heeb 3003', Tor. 3021', Br. line 3129', Lans 3145', Simp 3418', Arb. 3420' TD 3439' 5" @ 3431' CO DST 3232-42', opn 1 hr., rec. 15' wtry mud, 300# DST 3293-3321', opn 1 hr., gas in 35", rec. 950' free gassy oil, 525# CO to 3438' FU 750' oil 35", 1500A S/4.56 boph 1st hr. S/3.42 boph P/96 bopd Comp. 25 bopd
		COMPLETED

County **Stafford** State **Kansas**

Sec. **8** (Blk. Twp.) **21** (Sur. Rge.) **11W** Map No.

Operator **Duke & Wood**

Well No. **1** Farm **Kasselman**

Elev. Location **NW NW NW**

0							

**330** Ft. From **N** Line **NW**

**330** Ft. From **W** Line Quarter

Ist. Report **DEC 1 1954**

Completion

Remarks

**Co. tools**

Spudding Date **11-30-54**

Drlg. Data **San Dago Pool**

**FIRST REPORT**

**FABEN GILSTRAP**

County Stafford State Kansas  
 Sec. 8 (Blk. 21) (Sur. 11W) (Twp. Rge.) Map No.  
 Operator Duke & Wood  
 Well No. 1 Farm Kasselman  
 Elev. 1808 Location NW NW NW

0					

**COMPLETE**

330 Ft. From N Line NW  
330 Ft. From W Line Quarter  
 Ist. Report DEC 29 1954  
 Completion \_\_\_\_\_  
 Remarks San Dago Pool  
Co. tools  
 Spudding Date 11-30-54

Drlg. Data Oil well TD 3439  
8" @ 244 Anhy 564 Heeb. 3003  
Tor. 3021 Br. lime 3129 Lans. 3145  
Simp. 3418 Arb. 3420 TD 3439  
5" @ 3431 CO DST 3232-42 open 1 hr.  
Rec. 15' wtry mud 300# DST 3293-3321  
open 1 hr. gas in 35 min. Rec. 950'  
free gassy oil 525# CO to 3438  
FU 750' oil -35-min. 1500 A S/ 4.56  
boph 1st hr. S/ 3.42 boph P/- 96 bopd  
Comp. 25 bopd

**FABEN GILSTRAP**