

Stafford

KANSAS

DX 78-1

Section 8 Township 21 Range 12W

Well No. #1 Salem

Company Alpine & Parrish

NORTH

				0			

WEST

EAST

SOUTH

SEC.	8	TWP.	21	R.	12W
------	---	------	----	----	-----

WELL NO.

#1 Salem

FARM

COMPANY

Alpine & Parrish

CONTRACTOR

Quaker

Semi Wildcat.

Ft. from N. Line

330


Ft. from S. Line

Ft. from E. Line

330

Ft. from W. Line

SW SW SE

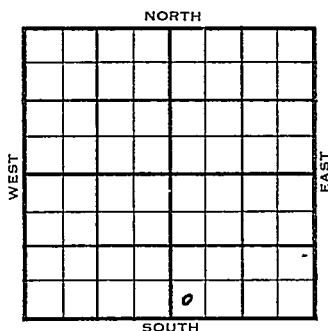

1954

ELEVATION

1862'

REPORT

11/23

Location

1955

2/2

Spud 11-23-54

D&A

TD 3521'

8-5/8" @ 286'

Anhy 665', Heeb. 3100', Br lime

3230', Mans. 3245'

DST 3369-3414', opn 1 hr., rec. 60' mud, 700#

Arb. 3484'

TD 3490'

5" @ 3486'

Cong. 3465', Simp. 3478'

DD 3520'

DD 3521', wtr.

PB 3517'

7 gwph

20/3510-15, B/3 go 5 gw 12 hrs., 500A

FU 500' wtr.

D&A

ABANDONED

County **Stafford** State **Kansas**

Sec. 8 (Blk.) 21 (Sur.) 12W Map No.

Operator Alpine & Parrish

Well No. **1** Farm **Salem**

Elev.	Location	SW	SW	SE
-------	----------	----	----	----

FIRST REPORT

330 Ft. From S Line SE

330 Ft. From W Line Quarter

1st. Report NOV 23 1954

Completion

Remarks

Quaker - Contr. "


Spudding Date

Drlq. Data Semi Wildcat

Location

FABEN GILSTRAP

County Stafford State Kansas
 Sec. 8 (Blk.) 21 (Sur.) 12W Map No.
 Operator Alpine & Parrish
 Well No. 1 Farm Salem
 Elev. 1862 Location SW SW SE

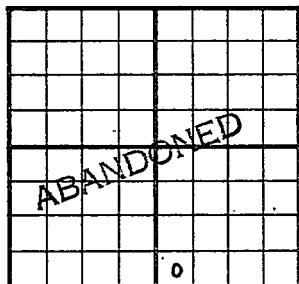

330 Ft. From S Line SE
330 Ft. From W Line Quarter
 1st. Report
 Completion FEB 2 1955
 Remarks Semi Wildcat
Quaker - Contr.
 Spudding Date 11-23-54

Drlg. Data D & A TD 3521
8 5/8" @ 286 Anhy 665 Heeb. 3100
Br. lime 3230 Lans. 3245 DST 3369-3414
open 1 hr. Rec. 60' mud 700# Arb. 3484
TD 3490 5" @ 3486 Cong. 3465
Simp. 3478 DD 3520 DD 3521 wtr.
PB 3517 7 gwph 20/ 3510-15 B/ 3 go
5 gw 12 hr. 500 A FU 500' wtr.
D & A

FABEN GILSTRAP