


Section 9 Township 21 Range 13W

Well No. 1 Fanshier

Company Petroleum Inc.

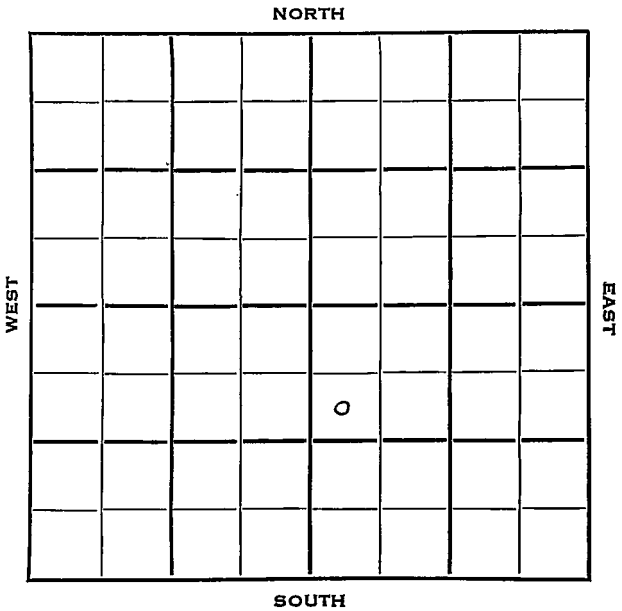

Stafford


Sec. 9 Twp. 21 R. 13WWell No. 1 Fanshier FarmPetroleum Inc. CompanyGarvie - Contr. Contractor990 Ft. from N. Line

_____ Ft. from S. Line

_____ Ft. from E. Line

330 Ft. from W. Line

SW NW SE

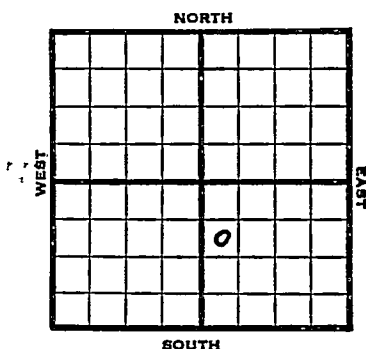

1953 Elev. 1894' REPORT

4/1 Spud 3-26-53
8" @ 283
Anhy 773
Drlg 2640

4/9 "

4/15 Spud 3-26-53
D&A
TD 3676
8" @ 283
Anhy 773, Heeb 3195, Br lim@ 3317,
ans 3319
DST 3343-3405, opn 1 hr., rec. 480'
sw, 580#
DST 3408-25, opn 1 hr., rec. 50' mud
1040#
DST 3444-84, opn 40 mins., rec. 10'
mud,
Arb. 3639
DST 3640-45, opn 1 hr., rec. 55'
ocm, 185#
DST 3641-51, opn 1 hr., rec. 30'
vhocm, 60' hocm, 220#
DST 3648-57, opn 1 hr., rec. 35' hocm
120' vhocm, 75#
DST 3642-63, opn 1hr., rec. 60' socm,
163#
TD 3676
D&A

ABANDONED

County Stafford State KansasSec. 9 (Blk. Twp.) 21 (Sur. Rge.) 13W Map No.Operator Petroleum Inc.Well No. 1 Farm FanshierElev. Location SW NW SE

990 Ft. From N Line SE330 Ft. From W Line QuarterIst. Report APR 1 1953

Completion _____

Remarks _____

Garvie - Contr.Spudding Date 3-26-53

Drlg. Data

8" @ 283 Anhy 773 drlg. 2640

