


Stafford

KANSAS

SECTION 9 TOWNSHIP 21 RANGE 13W

WELL NO. #2 Fanshier

COMPANY Hilton Drlg.

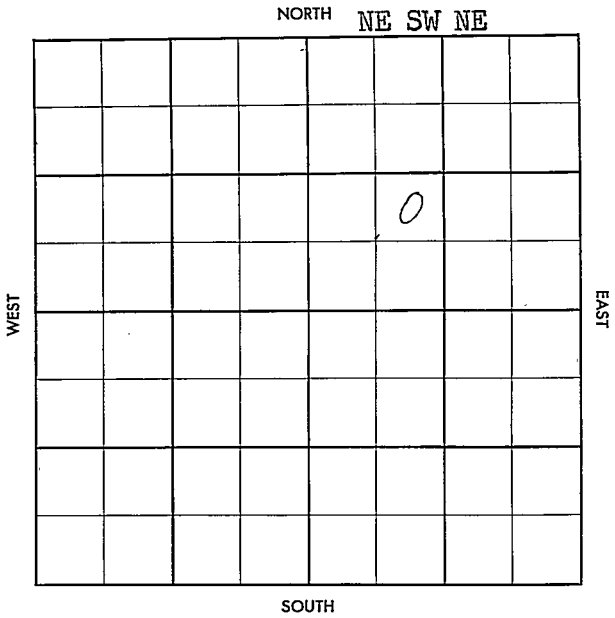


County Stafford Elev. _____
 Sec. 9 Twp. 21 Rgs. 13W
 Company Hilton Drlg.
 Farm Name Fanshies No. 2

TOPS	DEPTH	LOG	DATUM	Loc. in Sec.
Anh.				NE SW NE
Tp.				
H.				
Tr.				
Dg.				
Bl.				
L.				Geol. _____
K.C.				Contr. _____
B.K.C.				<u>Hilton Drlg.</u>
Ce.				
C.				
M.				Pool
M.				<u>Schaeffer</u>
K.				
Mz.				
Mq.				
V.				
S.				
S.				
A.				
R.				
PE.				
G.				
T.D.				

MAY 8 '57			

FIRST REPORT

Date Comm. M I R

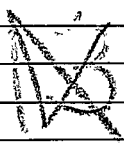

Co.
No.
Lsg.
No.
Sec.
T.
R.

County Stafford Elev. 1889
 Sec. 9 Twp. 21 Rge. 13W
 Company Hilton Drlg.
 Farm Name Fanshier No. 2

TOPS	DEPTH	LOG	DATUM
Anh.	760		
Tp.			
H.	3177		
Tr.	3198		
Dg.	3214		
Bl.	3295		
L.	3310		
K.C.			
B.K.C.	3521		
Ce.			
C. <u>shly</u>	3533		
M.			
M- <u>ca</u> <u>cht</u>	3584		
K.			
Mz.			
Mo.			
V.			
S.			
S.			
A.	3659		
R.			
PE.			
G.			
T.P.	3685		

Loc. in Sec. N^o SW NE
 Geol. _____
 Contr. Hilton Drlg
 Pool Schaeffer

MAY 22 57
 0
ABANDONED

Date Comm. " M I R MAY 15 57 5-7-57 85/8
123/150 1/3302 MAY 22 57
DST 3324-68 90" rec 300'
500W M FP 0-90 BHP 1190
120" DST 3447-82 30" rec
10' Md Full presso DST 3520-60
90" rec 150' 500' GCM FP
25-85 BHP 135' 20" DST
3532-62 90" 1170' 900' rec

210' MCW BHP 125⁰⁰/20

DEW