

Stafford

**KANSAS**

9


21

13W

SECTION \_\_\_\_\_ TOWNSHIP \_\_\_\_\_ RANGE \_\_\_\_\_

WELL NO. #1 C.M. Fanshier

COMPANY Texas Company

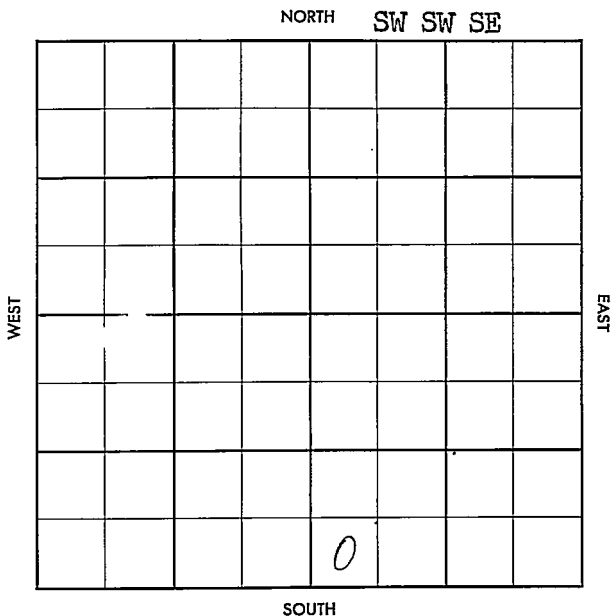

County Stafford Elev. \_\_\_\_\_  
 Sec. 9 Twp. (21) Rge. 13W  
 Company Texas Company  
 Farm Name C. M. Fanshier No. 1

TOPS	DEPTH	LOG	DATUM
Anh.	759		
Tp.			
H.			
Tr.			
Dg.			
Bl.			
L.			
K.C.			
B.K.C.			
Ce.			
C.			
M.			
M.			
K.			
Mz.			
Mo.			
V.			
S.			
S.			
A.			
R.			
Pe.			
G.			
T.D.			

Loc. in Sec. SW SW SE  
 Geol. \_\_\_\_\_  
 Contr. Powell Drlg.  
 Pool W. Hazel

FIRST REPORT	
MAR 20 57	
0	

Date Comm. 3-16-57

~~13~~

Co.  
 Loc.  
 No.  
 T.  
 R.

County Stafford Elev. 1891  
 Sec. 9 Twp. 21 Rge. 13W  
 Company Texas Company  
 Farm Name C. M. Fanshier No. 1

TOPS	DEPTH	LOG	DATUM	Lot in Sec.
Anh.	750			SW SW SF
TP.				
H.	3199			
Tr.				
Dg.	3235			
Bl.	3322			
L.	3336			
K.C.				Geol.
B.K.C.				Concr.
Ce.				Powell Drl.
C.		3560		
M.				Pool
M.				W. Hazel
K.				
Mz.				
Mo.				
V.				
S.		3627		
S.				
A.		3675		
R.				
PE.				
G.				
TP.	3685			

APR 17 '57
ABANDONED
0

Date Comm. 3-16-57 \* 77'57 10 5/8 @ 768

1450 DST 3418-32 90" 45'

SWCM FP 30-30 920/20

10' ahead of DST 3480-3500

1hr 10' Md (SSG) BHP

230/30 DST 3525-43 1hr

225' SW. FP 30-125 BHP

1075/30 DST 3578-92 1hr

10' Md (SSG) BHP 20/30" DST

3574-3620 1hr 10' HOCM FP

10-25 BHP 40/30 7 1/2 @  
 3684/75 APR 10 '57 CO 3685  
 +st dry 28/3678-85 +st  
 dry 1 1/2 +st 2 Goph +  
 4 Gwph 3 hrs PD 3730  
 PB 3643 104/3594-3620  
 +st scum oil +29 Gwph 1hr  
 P. 3 1/2 Gwph +scum oil  
 5th. hr 1 1/2 +st 5 G0 + 11  
 Gw 1hr 1 1/2 +st 7 G0 + 16  
 Gwph 1hr APR 17 '57 Frac \$  
 Ld no +st PB 3497  
 22/3462-70 No show A  
 \$ 38 BSW 6 hrs

DEW