


Section 9 Township 21 Range 13W

Well No. #1 Hanter

Company Petroleum, Inc.

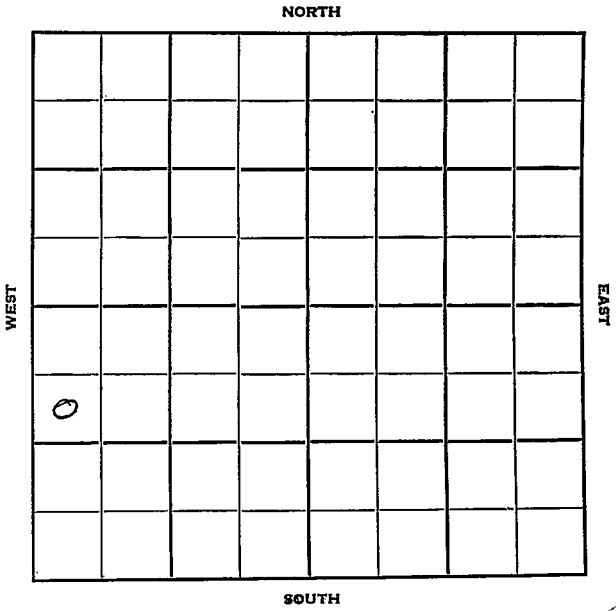

Stafford

Sec. 9 Twp. 21 R. 13W ✓

Well No. #1 Hanter Farm

Petroleum Inc. Company

Garvey Contractor

Semi Wildcat


990 Ft. from N. Line

\_\_\_\_\_ Ft. from S. Line

\_\_\_\_\_ Ft. from E. Line

330 Ft. from W. Line

SW NW SW

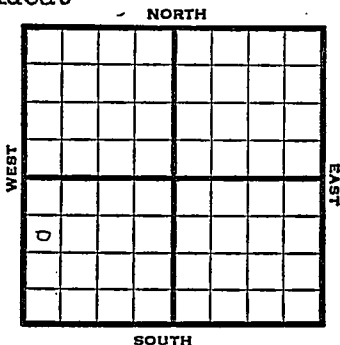

1951

Elev. 1896: REPORT

11/14 RUR

11/28 Spud 11-12-51  
D&A TD 3689  
8" @ 200

Anhy 779	Lans. 3331
Heeb. 3201	BKC 3549
Tor. 3222	Cong. 3599
Doug 3229	Viola 3598
Simp 3602	Arb. 3639

DST 3640-44 opn  $\frac{1}{2}$  hr. Rec. 7' mud  
DST 3642-49 opn 1 hr. Rec. 30' mud  
TD 3689

D&A **ABANDONED**



County Stafford State Kansas

Sec. 9 (Blk. 21 (Sur. 13W (Twp.) (Rge.) Map No.

Operator Petroleum Inc.

Well No. 1 Farm Harter

Elev. 1896 Location SW NW SW


990' Ft. From N Line SW

330' Ft. From W Line Quarter

Ist. Report

Completion NOV 28 1951

Remarks Semi Wildcat

Garvey Oil - Contr.

Spudding Date 11-12-51

Drlg. Data D & A TD 3689

8" @ 200 Anhy 779 Heeb. 3201

Tor. 3222 Doug. 3229 Lans. 3331

B KC 3549 Cong. 3590 Viola 3598

Simp. 3602 Arb. 3639 DST 3640-44

open 1/2 hr. Rec. 7' mud DST 3642-49

open 1 hr. Rec. 30' mud TD 3689

D & A

J. E. TYRA