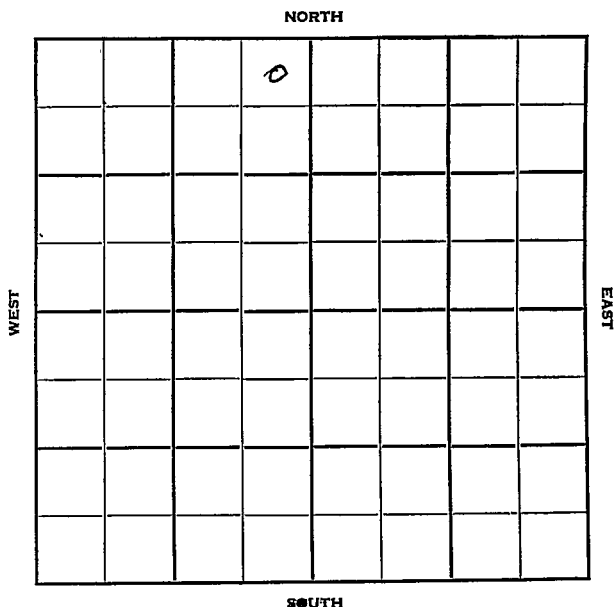


Section 9 Township 21 Range 14WWell No. #1 AsherCompany Westgate-Greenland

Stafford

Sec. 9 Twp. 21 R. 1/W

Well No. #1 Asher Farm

Westgate-Greenland Company

Jackson Drlg. - Contr. Contractor

Wildcat


330' Ft. from N. Line

 Ft. from S. Line

330' Ft. from E. Line

 Ft. from W. Line

NE NE NW

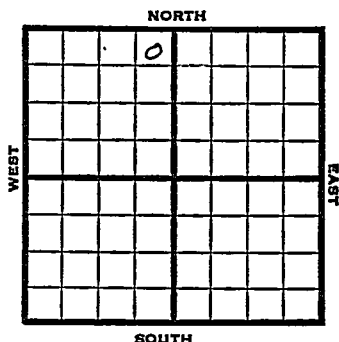

1951 Elv. 1938' REPORT

4/25

Spud 4-22-51
8" @ 855

WOC

5/9

Spud 4-22-51
D&A TD 3680
8" @ 855'
Anhy 853-72 Heeb. 3207
Br Lime 3307
Lans. 3316
DST 3310-48 opn 1 hr
Rec. 10' mud DST 3398-3407
opn 1/2 hr Rec 15' mud
DST 3442-87 opn 1 hr
Rec. 75' mud Simp. 3590
Arb. 3638 TD 3680
D&A

ABANDONED

County Stafford State Kansas
 Sec. 9 (Blk.) 21 (Sur.) 14W Map No.
 Operator Westgate-Greenland
 Well No. 1 Farm Asher
 Elev. Location NE NE NW

330 Ft. From N Line NW330 Ft. From E Line Quarter1st. Report APR 25 1951


Completion

FIRST REPORT

Remarks

Jackson Drlg. - Contr.Spudding Date 4-22-51Drlg. Data Wildcat8" @ 855 WOC

J. E. TYRA

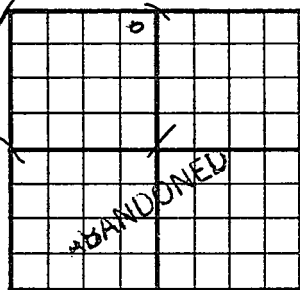County Stafford State KansasSec. 9 (Blk.) 21 (Sur.) 14W Map No.Operator Westgate-GreenlandWell No. 1 Farm AsherElev. 1938 Location NE NE NW330 Ft. From N Line NW330 Ft. From E Line Quarter

1st. Report

Completion MAY 9 1951Remarks WildcatJackson Drlg. - Contr.Spudding Date 4-22-51Drlg. Data D & A TD 36808" @ 855 Anhy 853-72 Heeb. 3207Br. lime 3307 Lans. 3316 DST 3310-48open 1 hr. Rec. 10' mud DST 3398-3407open $\frac{1}{2}$ hr. Rec. 15' mud DST 3442-87 open 1 hr.Rec. 75' mud Simp. 3590 Arb. 3638TD 3680 D & A

J. E. TYRA