
FORM 51 25M 8-50 WESTERN Rice KANSAS

Section 9 Township 21 Range 7 W

Well No. # 2 Deweese "B"

Company Petroleum Inc.

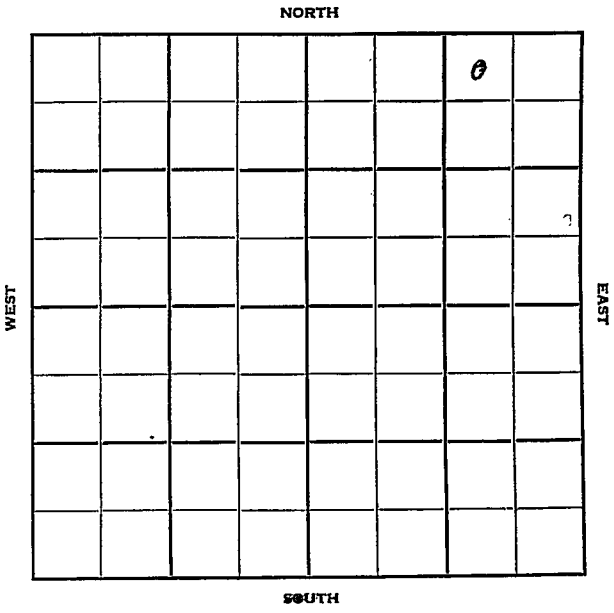

FORM 252-B
10M 10-50 PETROL Rice

KANSAS

Sec. 9 Twp. 21 R. 7W

#2 De Weese "B"

Well No. ~~#1 Deweese "C"~~ Farm

Petroleum Inc. Company

Contractor


330 Ft. from N. Line

Ft. from S. Line

Ft. from E. Line

990 Ft. from W. Line

NW NE NE

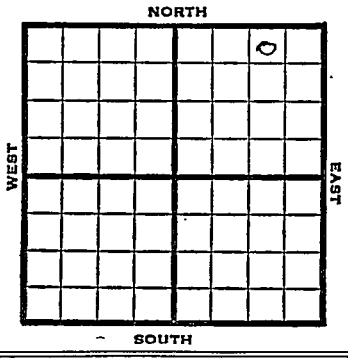


| 1952 | Elev. 1611' REPORT |
|---|---|
| 3/19 | Spud 3-9-52<br>8" @ 140'<br>Anhy 300 Cong. 3315<br>TD 3340'<br>7" @ 3339' WOC |
| 3/25 | NR |
| 4/1 | DD to 3341' Test 3½ BOPH 5% wtr.<br>DD to 3349' TD S/2 BOPH POP |
| 4/9 | DD to 3341 Test 3½ boph 5½ wtr<br>DD to 3349 TD S/2 boph POP |
| 4/23 | P/50 BOPD |
| 4/30 | Spud 3-9-52 Oil Well<br>TD 3349 8" @ 140'<br>Anhy 300 Cong. 3315<br>TD 3340 7" @ 3339' DD 3341<br>3½ boph 5% wtr. DD 3349<br>S/ 2 boph Comp. 50 bopd |

**COMPLETED**

FORM 275 FOR SALE BY KANSAS BLUE PRINT CO.


County Rice State Kansas

Sec. 9 (Blk. Twp.) 21 (Sur. Rge.) 7W Map No.

Operator Petroleum Inc.

Well No. 1 Farm Deweese "C"

Elev. Location NW NE NE

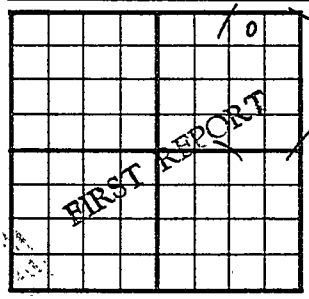


330 Ft. From N Line NE

990 Ft. From E Line Quarter

1st. Report MAR 1 9 1952

Completion

Remarks

Spudding Date 3-9-52

Drlg. Data

8" @ 140 Anhy 300 Cong. 3315

TD 3340 7" @ 3339 WOC

J. G. McGEHEE

Form 26 200 Bks. 11-49 Petrol

Kansas

Map No. _____ Sec. 9 Twp. 21 R. 7W

Well No. 2 DeWeese "B"

Petroleum Inc. Company

CORRECTION Contractor

NW NE NE

330 Ft. from N. Line


_____ Ft. from S. Line

990 Ft. from E. Line

_____ Ft. from W. Line

Rice County

SECTION PLAT

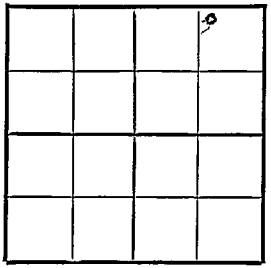

Location _____

Rig up _____

Drilling and Remarks:

Reported

#1 DeWeese "C"

RECORD

Cased _____ in., _____ ft.

Sand _____

Gas _____

Oil _____

Total Depth _____

PRODUCTION

1st 24 hrs. Nat. _____

1st 24 hrs. after shot _____

Gas _____ Cu. Ft.

Dry Hole _____

Abandoned _____

Date

APR 2 1952 19

J. G. McGEHEE Scout

FORM 275 FOR SALE BY KANSAS BLUE PRINT CO.


County Rice State Kansas

Sec. 9 (Blk. Twp.) 21 (Sur. Rge.) 7W Map No.

Operator Petroleum Inc.

Well No. 2 Farm DeWeese "B"

Elev. 1611 Location NW NE NE

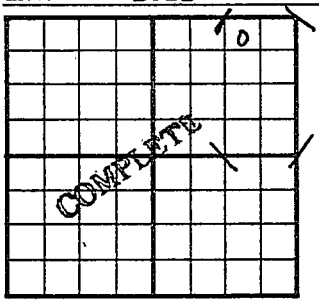


330 Ft. From N Line NE

990 Ft. From E Line Quarter

1st. Report

Completion APR 3 0 1952

Remarks

Spudding Date 3-9-52

Drlg. Data Oil well TD 3349

8" @ 140 Anhy 300 Cong. 3315

TD 3340 7" @ 3339 DD 3341

3½ boph 5% water DD 3349 S/ 2 boph

Comp. 50 bopd

J. G. McGEHEE