
FORM 51 25M 8-50 WESTERN

Rice KANSAS

Section 9 Township 21 Range 7W

Well No. #1 Dewes "B"

Company Petroleum, Inc.

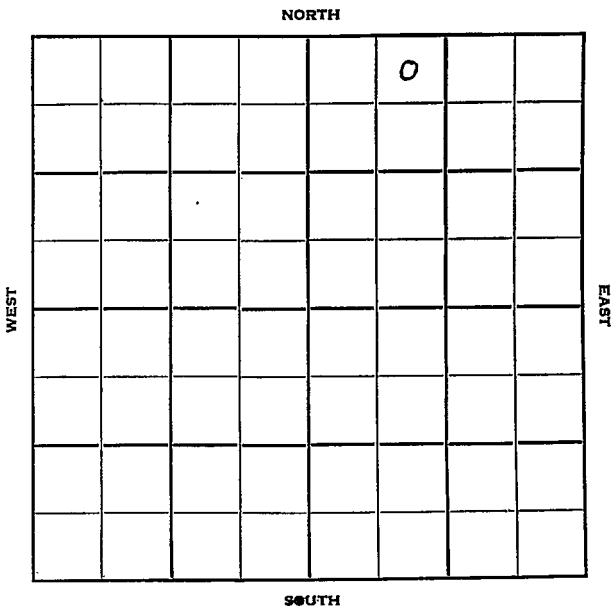

FORM 252-B
10M 10-50 PETROL

KANSAS Rice

Sec. 9 Twp. 21 R. 7-W ✓

Well No. #1 Dewes "B" Farm

Petroleum Inc. Company

Aylward Contractor


330 Ft. from N. Line

Ft. from S. Line

Ft. from E. Line

990 Ft. from W. Line

NE NW NE

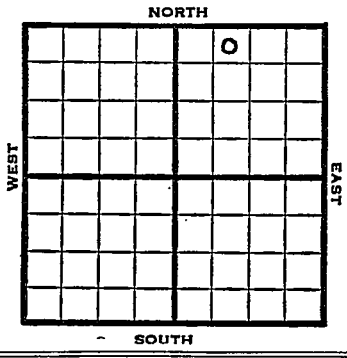

1950	Elev. 1612' REPORT
12/13	Spud 12-9-50 8 5/8" @ 138 Drlg 1100'
1951 1/10	Spud 12-9-50 Oil Well TD 3347 8-5/8" @ 138' Cong. 3337-3341 5" @ 3338 TD 3345 2 boph DD 3347 Comp. 50 bopd COMPLETED

FORM 275 FOR SALE BY KANSAS BLUE PRINT CO.


County Rice State Kansas

Sec. 9 (Blk. Twp.) 21 (Sur. Rge.) 7W Map No.

Operator Petroleum Inc.

Well No. 1 Farm Dewes "B"

Elev. Location NE NW NE

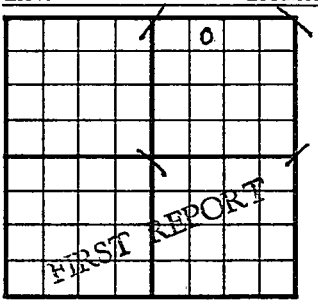

330 Ft. From N Line NE

990 Ft. From W Line Quarter

1st. Report DEC 13 1950

Completion

Remarks

Aylward - Contr.

Spudding Date 12-9-50

Drlg. Data

8 5/8" @ 138 drlg. 1100

J. E. TYRA

FORM 275 FOR SALE BY KANSAS BLUE PRINT CO.


County Rice State Kansas

Sec. 9 (Blk. Twp.) 21 (Sur. Rge.) 7W Map No.

Operator Petroleum Inc.

Well No. 1 Farm Dewes "B"

Elev. 1612 Location NE NW NE

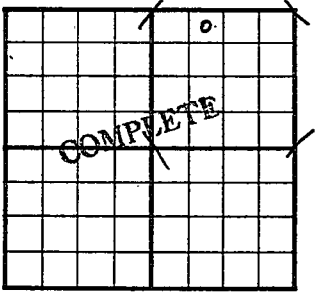

330 Ft. From N Line NE

990 Ft. From W Line Quarter

1st. Report

Completion JAN 1 0 1951

Remarks

Aylward - Contr.

Spudding Date 12-9-50

Drlg. Data Oil well TD 3347

8 5/8" @ 138 Cong. 3337-3341 5" @ 3338

TD 3345 2 boph DD 3347 Comp. 50 bopd

J. E. TYRA