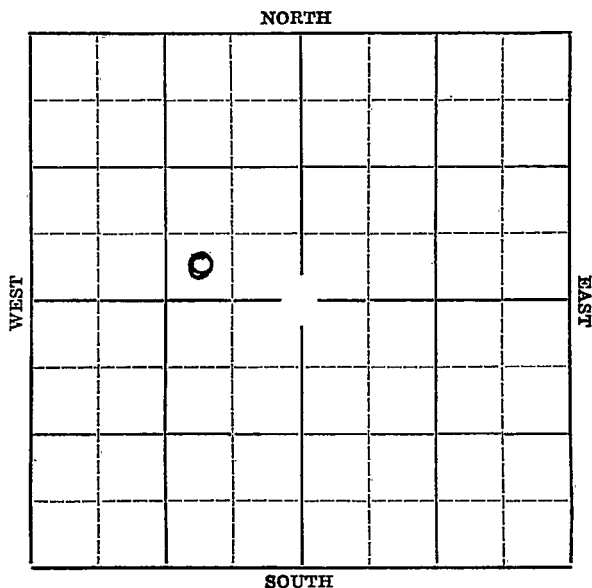
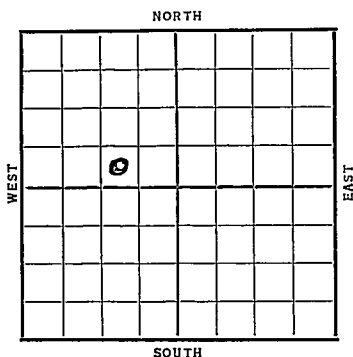


Section 9 Township 21 Range 7-WWell Number 1 GossmanCompany Garden-Haynes

Sec. 9 Twp. 21 R. 7-WWell No. #1 Gossman FarmGarden-Haynes Company Ft. from N. Line330 Ft. from S. Line Ft. from E. Line990 Ft. from W. Line

Elev. 1613

Date 1937

REPORT

3/3 Rig3/11 Surface hole.3/18 12" @ 93'. Drlg. 1860'.3/25 Drlg. 2055'.4/2 Drlg. 3155'.4/7 Conglomerate 3355'.

T. D. 3365½'.

Potential 2831.

COMPLETED

KANSASMap No. 49 Sec. 9 Twp. 21 R. 7WWell No. 1 GossmanGarden-Haynes Company

Contractor

SECTION PLAT

	0		

_____ Ft. from N. Line

330 Ft. from S. Line

_____ Ft. from E. Line

990 Ft. from W. Line**FIRST REPORT**

Location _____

Rig up _____

Drilling and Remarks:

Pig**RECORD**

Cased _____ in., _____ ft.

Sand _____

Gas _____

Oil _____

Total Depth _____

PRODUCTION

1st 24 hrs. Nat. _____

1st 24 hrs. after shot _____

Gas _____ Cu. Ft.

Dry Hole _____

Abandoned _____

Date

MAR 3 1937 19S. J. LEWIS Scout

KANSAS

Rice

Map No. _____ Sec. 9 Twp. 21 R. 7WWell No. 1 GossmanGardner-Haynes Company

Contractor

SECTION PLAT

_____ Ft. from N. Line

330 Ft. from S. Line

_____ Ft. from E. Line

990 Ft. from W. Line

COMPLETED

Location _____

Rig up _____

Drilling and Remarks:

Conglomerate
3255

Potential

2831

RECORD

Cased _____ in., _____ ft.

Sand _____

Gas _____

Oil _____

Total Depth 3265 1/2

PRODUCTION

1st 24 hrs. Nat. _____

1st 24 hrs. after shot _____

Gas _____ Cu. Ft.

Dry Hole _____

Abandoned _____

Date

APR 7 1937 19

S. J. LEWIS

Scout