


KANSAS

Section 9 Township 21 Range 7-W


Well Number 2 Theede

Company Douglas et al

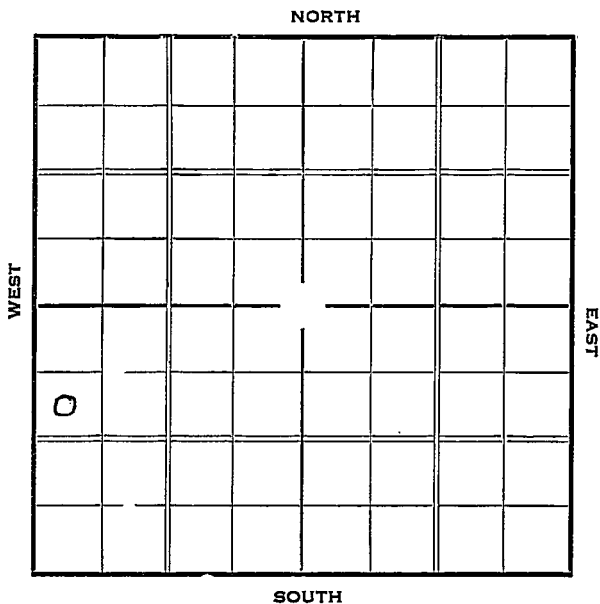

KANSAS RiceSec. 9 Twp. 21 R. 7-WWell No. #2 Theede FarmDouglas et al Company990 Ft. from N. Line Ft. from S. Line Ft. from E. Line330 Ft. from W. Line

Elev. 1616

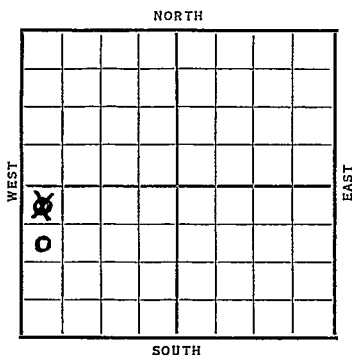Date
1937

REPORT

2/10

Location

2/18

"

2/26

Cellar

3/4

Rig

3/11

10" @ 156'. Drlg. 1580'.

3/18

Drlg. 3000'.

3/25

Conglomerate 3353' set 8". WOC.

3/31

Conglomerate 3353'.

T.D. 3360'.

Potential 2950 natural.

COMPLETED

KANSAS

Map No. _____ Sec. 9 Twp. 21 R. 2WWell No. 2 TheedeDouglas & Co Company_____
Contractor

SECTION PLAT

0			

990 Ft. from N. Line

_____ Ft. from S. Line

_____ Ft. from E. Line

330 Ft. from W. Line

FIRST REPORT

Location ✓

Rig up _____

Drilling and Remarks:

RECORD

Cased _____ in., _____ ft.

Sand _____

Gas _____

Oil _____

Total Depth _____

PRODUCTION

1st 24 hrs. Nat. _____

1st 24 hrs. after shot _____

Gas _____ Cu. Ft.

Dry Hole _____

Abandoned _____

Date

FEB 10 1937

19

S. J. LEWIS

Scout

KANSAS *Rice*Map No. _____ Sec. 9 Twp. 21 R. 7WWell No. 2 TheedleDouglas et al Company_____
Contractor**SECTION PLAT**

990 Ft. from N. Line

_____ Ft. from S. Line

_____ Ft. from E. Line

330 Ft. from W. Line**COMPLETED**

Location _____

Rig up _____

Drilling and Remarks:

*Conglomerate**3353**Potential**2950 natural***RECORD**

Cased _____ in., _____ ft.

Sand _____

Gas _____

Oil _____

Total Depth 3360**PRODUCTION**

1st 24 hrs. Nat. _____

1st 24 hrs. after shot _____

Gas _____ Cu. Ft.

Dry Hole _____

Abandoned _____

Date

MAR 31 1937 19

S. J. LEWIS Scout