

Rice


KANSAS

Form 51-5M 5-37 Petrol

Section 9 Township 21 Range 7-W

Well No. #3 Snyder

Company Mid-Plains Pet. Corp.

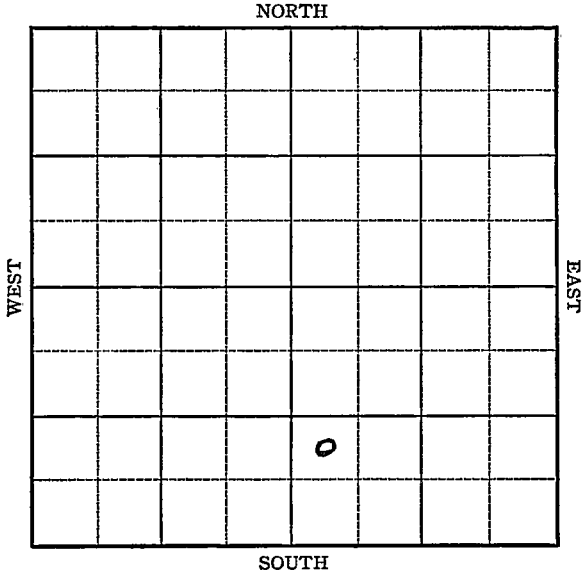

1938

1/19

7" @ 3360'.

Cong. 3360'.

T.D. 3378'.

Shot 30 qts.

Potential 289 bbls.

COMPLETED

KANSAS

Rice

Map No. _____ Sec. 9 Twp. 21 R. 7WWell No. 3 SnyderMid-Plains Pet. Corp. Company

Contractor

FIRST REPORT

NW SW SE

____ Ft. from N. Line

990 Ft. from S. Line

____ Ft. from E. Line

330 Ft. from W. Line

SECTION PLAT

		0	

Location _____

Rig up _____

Drilling and Remarks:

Cellar

RECORD

Cased _____ in., _____ ft.

Sand _____

Gas _____

Oil _____

Total Depth _____

PRODUCTION

1st 24 hrs. Nat. _____

1st 24 hrs. after shot _____

Gas _____ Cu. Ft.

Dry Hole _____

Abandoned _____

Date

OCT 27 1937

19

J. D. Hatfield

Scout

Rice

KANSASMap No. 49 Sec. 9 Twp. 21 R. 7WWell No. 3 SnyderMid-Plains Pet. Corp. Company

Contractor

COMPLETED

NW SW SE

SECTION PLAT

		0	

____ Ft. from N. Line

990 Ft. from S. Line

____ Ft. from E. Line

330 Ft. from W. Line

Location _____

Rig up _____

Drilling and Remarks:

*Shot 30 gts**Lot 289***RECORD**Cased 7 in., 3360 ft.~~Sand~~ *Cong* 3360

Gas _____

Oil _____

Total Depth 3378**PRODUCTION**

1st 24 hrs. Nat. _____

1st 24 hrs. after shot _____

Gas _____ Cu. Ft.

Dry Hole _____

Abandoned _____

Date

JAN 19 1938 19H. D. Hatfield

Scout