

KANSAS

Rice

Section 9 Township 21 Range 7WWell No. 1 TheedeCompany S E Likins et al

Wherry Pool

NORTH

WEST

EAST

SOUTH

KANSAS

Rice



Sec. 9 Twp. 21 R. 7W

Well No. #1 Theede Farm

S. E. Likins et al Company

Wherry Pool (Ferrell Drlg., Cont.)


990' Ft. from N. Line

Ft. from S. Line

Ft. from E. Line

990'

Ft. from W. Line

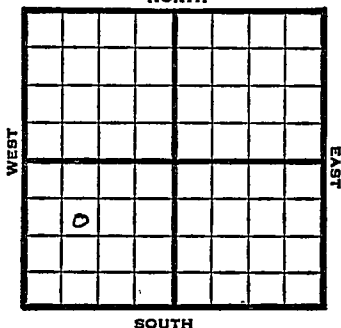

SE NW SW

1949

E lev 1615' REPORT

5/11 All well plugged
Drlg. 2000'

5/18 8" @ 132 -
Cong 3361
TD 3361'
5" @ 3361'

5/25 SD

6/1 "

6/8 Lans. 2910'
Miss 3403'
TD 3417'
Aband.

ABANDONED

Kansas

Map No. _____ Sec. 9 Twp. 21 R. 7WWell No. 1 TheedeS. E. Likins etal.

Company

Ferrell Drlg.

Contractor

SE NW SW

FIRST REPORT
SECTION PLAT990


Ft. from N. Line

Ft. from S. Line

Ft. from E. Line

990

Ft. from W. Line

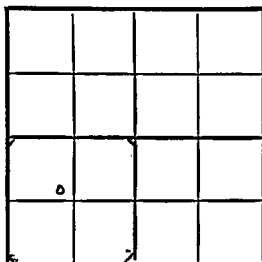

Rice County

RECORD

Location _____

Cased _____ in., _____ ft.

Rig up _____

Sand _____

Drilling and Remarks:

Gas _____

Oil _____

Total Depth _____

All wells plugged

drlg. 2000

PRODUCTION

1st 24 hrs. Nat. _____

1st 24 hrs. after shot _____

Gas _____ Cu. Ft.

Dry Hole _____

Abandoned _____

Date

MAY 11 1949

19

S. J. LEWIS

Scout

Rice County Kansas State

Map No. K 49 Sec. 9 Twp. 21 R. 7W

Well No. 1 Theede

S. E. Likins et al. Company

ABANDONED

Contractor

SE NW SW

E 1/4 15
SECTION PLAT

990 Ft. from N. Line

 Ft. from S. Line

 Ft. from E. Line

990 Ft. from W. Line

Wherry Pool

Remarks:

Line 2910

Miss 3403

YD 3417

Date

JUN 8 1949

Scout

S. J. LEWIS