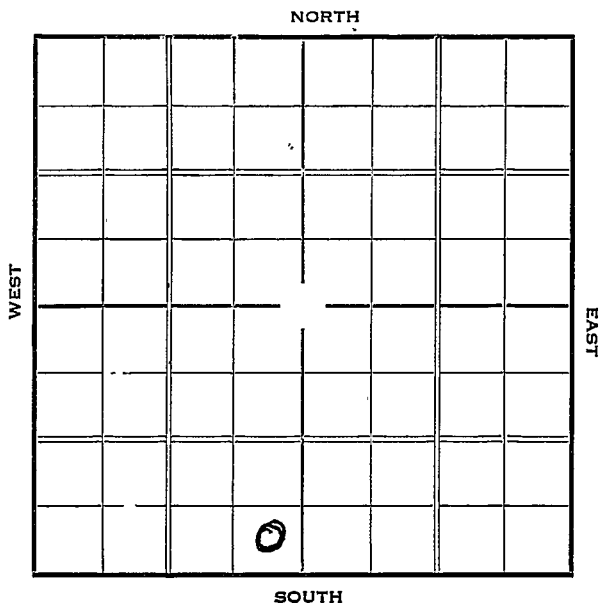
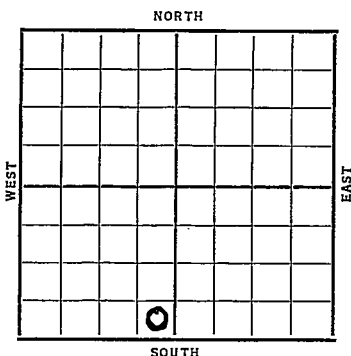


KANSAS

Rice

Section 9 Township 21 Range 7-WWell Number #16 TheedeCompany L.E. Douglas

Sec. 9 Twp. 21 R. 7-WWell No. #16 Theede FarmL.E. Douglas Company Ft. from N. Line330 Ft. from S. Line330 Ft. from E. Line Ft. from W. Line

Date	REPORT
1937	
6/30	Cellar
7/9	R U R
7/16	15" @ 109'. Drlg. 2100'.
7/23	Topeka 2400'. Lans. 2890'.
	Drlg. 3285'.
7/30	Cong. & 8" @ 3349'.
	At 3351 flowed 410-6 hrs.
	Drlg. 3356'.
8/4	8" @ 3349'.
	Cong. 3349'.
	T.D. 3376'.
	Flowed 1373 bbls. 6 hrs.
	Pot. 5203 bbls.
	COMPLETED

Rice KANSASMap No. _____ Sec. 9 Twp. 21 R. 7^wWell No. 16 - TheedeL. E. Douglas Company
Contractor

FIRST REPORT

SECTION PLAT

	0		

____ Ft. from N. Line

330 Ft. from S. Line330 Ft. from E. Line

____ Ft. from W. Line

Location _____

Rig up _____

Drilling and Remarks:

Cellar

RECORD

Cased _____ in., _____ ft.

Sand _____

Gas _____

Oil _____

Total Depth _____

PRODUCTION

1st 24 hrs. Nat. _____

1st 24 hrs. after shot _____

Gas _____ Cu. Ft.

Dry Hole _____

Abandoned _____

Date

JUN 30 1927 19

H. D. Hatfield Scout

Rice **KANSAS**Map No. _____ Sec. 9 Twp. 21 R. 7WWell No. 16 - TheedeL. E. Douglas Company

Contractor

COMPLETED**SECTION PLAT**

_____ Ft. from N. Line

330 Ft. from S. Line330 Ft. from E. Line

_____ Ft. from W. Line

Location _____

Rig up _____

Drilling and Remarks:

flowed 1373/6 hrsPat - 5203**RECORD**Cased 8 in. 3349 ft.Sand Cong. 3349

Gas _____

Oil _____

Total Depth 3376**PRODUCTION**

1st 24 hrs. Nat. _____

1st 24 hrs. after shot _____

Gas _____ Cu. Ft.

Dry Hole _____

Abandoned _____

Date

AUG 4 - 1937H. D. Hatfield Scout