

KANSAS


Stafford

Form 51—5M—7-39—Palace

Section 9 Township 21 Range 11-W

Well No. #1 Smith

Company Shell

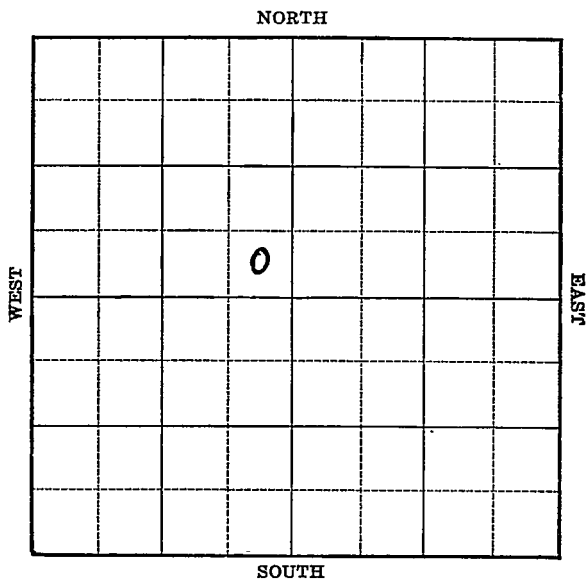


KANSAS

Stafford

Sec. 9 Twp. 21 R. 11-WWell No. #1 Smith FarmShell

Company

(Snider)

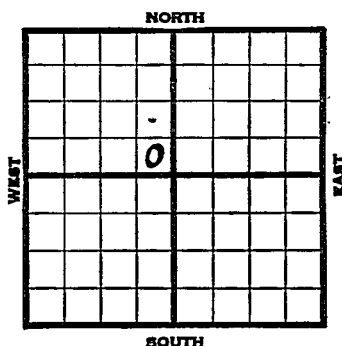 Ft. from N. Line330 Ft. from S. Line330 Ft. from E. Line~~230~~ Ft. from W. Line

Elv. 1779

1939	REPORT
12/6	Rotary.
12/14	"
12/21	Topêka 2706' Lans. 3137'
	Arb. 3403-05' S.O. Drilg.
12/28	Core 3405-10' 3½' recovery.
	S.O. Core 3410-15' S.O. 4½" at
	3408' RUST.
1940	
1/4	T.D. 3462' 550' water.
	P.B. to 3388'
	33 shots 3355-63'
	2 " 3365'
	36 shots 3363-71'
	Shut in 17 hrs. Flow 82 bbls.
	6 hours. Shut down.
1/11	" " " "
1/18	" " " "
1/25	" " " "
2/1	" " " "
	OVER

1940

2/7 Arb. 3403'
4" - 3408'
T.D. 3462'
P.B. to 3388'
Lans. 3137'
Sand 3355-61'
71 shots 3355-71'
Pump 378 oil plus 24 water.

COMPLETED

Stafford

KANSAS

Map No. 46 Sec. 9 Twp. 21 R. 11WWell No. 1 SmithShell

Company


Contractor

FIRST REPORT

SE NW

 Ft. from N. Line330 Ft. from S. Line Ft. from E. Line330 Ft. from W. Line

SECTION PLAT

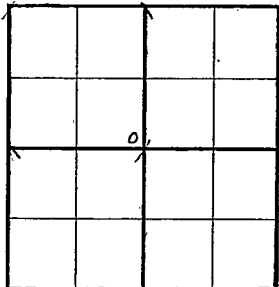

SNIDER POOL

Location Rig up

Drilling and Remarks:

Rotary

RECORD

Cased in., ft.Sand Gas Oil Total Depth

PRODUCTION

1st 24 hrs. Nat. 1st 24 hrs. after shot Gas Cu. Ft.Dry Hole Abandoned

Date

DEC 6 1939

19

S. J. LEWIS

Scout

Misc Small Maps

Cards

Tracing

France Map

Scarborough Map

Moody Map

Geological Dept.

Mocdy Flat Book

Stafford

KANSAS

Map No. 46 Sec. 9 Twp. 21 R. 11WWell No. 1 SmithShell

Company


CORRECTION

Contractor

SE NW

 Ft. from N. Line330 Ft. from S. Line330 Ft. from E. Line Ft. from W. Line

SECTION PLAT

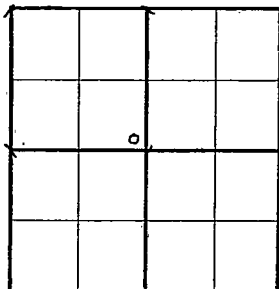

SNIDER POOL

Location Rig up Drilling and Remarks: Reported 330 from W. Line

RECORD

Cased in., ft.Sand Gas Oil Total Depth

PRODUCTION

1st 24 hrs. Nat. 1st 24 hrs. after shot Gas Cu. Ft.Dry Hole Abandoned

Date

DEC 6 1939S. J. LEWIS Scout

Misc. Small Maps.....
Cards.....
Tracing.....
France Map.....
Scarborough Map.....
Moody Map.....
Geological Dept.
Moody Flat Book

Map No. 46 Sec. 9 Twp. 21 R. 11WWell No. 1 SmithShell

Company

Contractor

COMPLETED

SE NW.

 Ft. from N. Line330 Ft. from S. Line330 Ft. from E. Line Ft. from W. Line

SECTION PLAT

SNIDER POOL

Location Rig up

Drilling and Remarks:

Cor 834034" @ 3408.P.B 3388' Lions. 3132Band 3355-6171 Skrt. 3355-71Pump. 375 oil plus.24 1/2 lbs.

RECORD

Cased in., ft.Sand Gas Oil Total Depth 3462

PRODUCTION

1st 24 hrs. Nat. 1st 24 hrs. after shot Gas Cu. Ft.Dry Hole Abandoned

Date

FEB 7 1940 19

S. J. LEWIS

Scout

Ray

Misc Small Map	<i>Ray</i>
Cards	<i>Ray</i>
Tracing	<i>Ray</i>
France Map	<i>Ray</i>
Scarborough Map	<i>Ray</i>
Moody Map	<i>Ray</i>
Geological Dept.	
Moody Flat Book	